

LADD. MISSISSIPPI BOARD OF WATER COMMISSIONERS

R39

WATER WELL DRILLERS LOG

CODED

5-29-65

Date: 5-29, 1965, Driller: McDonald & Hill, Inc. County: Lauderdale

(Name)

(1) Owner of Land: Nate Williamson
 (Name)
Meridian, Miss.
 (Address)

(2) Location: 1/4, 16, 5 15
 T R
5 miles South of Meridian
 (distance) (direction) (Nearest Town)

(3) Topography: (Hilly) (Flat) (Level)

(4) Purpose of Well: Domestic
 (Domestic Irrigation, Municipal, Industrial, Other)

Description & Color of Materials Sand, Clay, Red Clay, Shell, etc.	Thick- ness Feet	Depth Feet
Clay	0	10
Shale	10	12
Sand	12	21
H Shale	21	40
lig. Shale str.	40	52
white C sand	52	55
yellow white sand	55	63
H Shale	63	87
Fine shale	87	87
M Shale	87	105
Fine shale	105	112
M Shale	112	120
Sandy shale	120	128
M. Shale	128	135
Sandy Shale	135	170
H Shale	170	190

Information upon completion of well:

(1) Diameter 2 inches.

(2) Total Depth 190 ft. feet.


(3) Water Level 22 feet below top of ground.

(4) Cased to 87, Size 2"

(5) Screen: Size _____, Length _____

(6) Were any formations sealed against pollution?
 _____ yes, no.

CODED

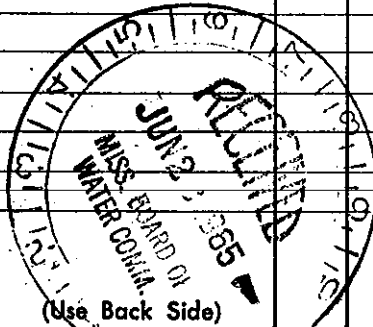

Well No.

Mail this copy to Board of Water Commissioners 429 Miss. St. Jackson, Miss.