

LAUD.
R 40
3-23-66
Date: 3-23-

WATER WELL DRILLERS LOG

CODED

1966, Driller: McDonald & Hill, Inc. County Landulate
(Name)

	Description & Color of Materials Sand, Clay, Red Clay, Shell, etc.	Thick- ness Feet	Depth Feet
(1) Owner of Land: <u>NATE WILLIAMSON</u> (Name)	CLAY	0	4
_____ <u>MERIDIAN MISS</u> (Address)	SAND	4	34
(2) Location: <u>1/4, 16 1/4, Sec. 5 11</u> _____ T R	SHALE SLIGNITE	34	45
_____ <u>5</u> miles <u>Sout</u> of <u>Meridian</u> (distance) (direction) (Nearest Town)	SANDY	45	68
(3) Topography: _____ (Hilly) (Flat) (Level)	SHALE	68	125
(4) Purpose of Well: <u>Domestic</u> (Domestic Irrigation Municipal, Industrial, Other)	SAND	125	138
	SOFT SHALE	138	156
	SAND ST SHALE	156	185

Information upon completion of well:


- (1) Diameter 4" WELL inches.
- (2) Total Depth 185' feet.
- (3) Water Level 18' feet below top of ground.
- (4) Cased to 75', Size 4"
- (5) Screen: Size _____, Length _____
- (6) Were any formations sealed against pollution?
_____ yes, _____ no.

If YES depth of formation _____

Why _____

Drillers Remarks: _____

CODED

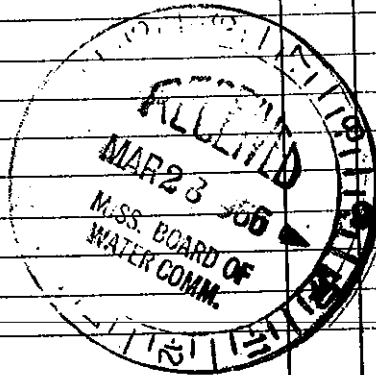

Well No. _____

(Use Back Side)

Mail this copy to Board of Water Commissioners 429 Miss. St. Jackson, Miss