

no county shown


MISSISSIPPI
BOARD OF WATER COMMISSIONERS
416 North State Street
Jackson, Mississippi 39201

WATER WELL DRILLERS LOG

Lauderdale
R 55
5-1-74

5.1.74 19 M^cDonald & Hill Lauderdale
date well completed firm name county well located

LANDOWNER:	description of formations encountered	from	to
(mailing address)			
<u>GLEEN HARRISON</u>	<u>CLAY SAND</u>	<u>0</u>	<u>10</u>
<u>Hwy 11 SOUTH</u>	<u>SAND</u>	<u>10</u>	<u>30</u>
<u>(mailing address)</u>	<u>SHALE</u>	<u>30</u>	<u>50</u>
WELL LOCATION:	<u>SAND ST SHALE</u>	<u>50</u>	<u>90</u>
sec. <u>16</u> T. <u>5</u> N. R. <u>15</u> E.	<u>SOFT MULKY SAND</u>	<u>90</u>	<u>145</u>
<u>SAVOY</u>	<u>ST SHALE</u>		
<u>SAVOY</u>	<u>SAND</u>	<u>145</u>	<u>160</u>
<u>SAVOY</u>	<u>SHALE</u>	<u>160</u>	<u>181</u>
<u>SAVOY</u>	<u>ROCK</u>	<u>181</u>	<u>187</u>
<u>SAVOY</u>	<u>FINE SAND</u>	<u>187</u>	<u>240</u>
WELL PURPOSE:			
(home, irrigation, municipal, industrial)			
WELL COMPLETION DATA:			
(1) diameter (inches) <u>4"</u>			
(2) total depth (feet) <u>240'</u>			
(3) static water level (feet) <u>Flow</u> above top of ground.			
(4) casing <u>PVC</u> <u>160'</u>			
(material) (depth)			
<u>4"</u>			
(size) If telescope see back.			
(5) screen			
(length) (depth to top)			
(size) (material)			
(6) pump <u>1</u> <u>10</u>			
(HP) (yield gpm)			
<u>E</u>			
(type power)			
(7) electric log (yes or no)			
(organization running log)			
(8) how well bottom plugged <u>OPEN</u>			
DRILLERS REMARKS:			

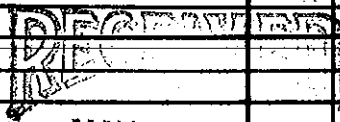

MAY - 8 1974