

Lauderdale
 R 2000
 8-89-75

MISSISSIPPI
 BOARD OF WATER COMMISSIONERS
 416 North State Street
 Jackson, Mississippi 39201

WATER WELL DRILLERS LOG


8-29-75^{13P} date well completed
 Terry Drilling Co. firm name
 Land county well located

LANDOWNER: A.C. Thompson Rt 5, Mdn. Miss. (mailing address)	description of formations encountered	from to	
	yellow clay	0	40
	sandy	40	70
	sand shale	80	100
	shale	120	200
	sandy	200	240
	clay	240	350
	sand & clay	350	425

WELL LOCATION:
 sec. 1 T 5 N R 1 E
 3 miles S of Mdn.
 (distance) (direction) (nearest town)

WELL PURPOSE:
 (home, irrigation, municipal, industrial)

- WELL COMPLETION DATA:
- (1) diameter (inches) 4"
 - (2) total depth (feet) 425'
 - (3) static water level (feet) 200' below top of ground.
 - (4) casing PVC 277' (material) (depth)
 (size) If telescope see back.
 - (5) screen No (length) (depth to top)
 (size) (material)
 - (6) pump 3/4 (HP) 5 (yield gpm)
 Sub (type power)
 - (7) electric log No (yes or no)
 (organization running log)
 - (8) how well bottom plugged open

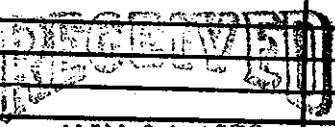

MAY 31 1976

DRILLERS REMARKS:
 MISS. BD. OF WATER COMM