

MISSISSIPPI DEPARTMENT OF NATURAL RESOURCES

Bureau of Land and Water Resources

Southport Mall

P.O. Box 10631

Jackson, Mississippi 39209

WATER WELL DRILLERS LOG


LAUDERDALE
R 2019

7/11/81
7-11-81
date well completed

McDonald & Hill
firm name

Lauderdale
county well located

LANDOWNER:	description of formations encountered	from	to
Sutcliffe Cole	Sand	0	40
RA#5 Box 153 Meridian (mailing address)	shales & lignite	40	105
WELL LOCATION: sec. 9 T 5 N R 15 E 1 1/2 miles N of Savoy (distance) (direction) (nearest town)	fine sand & shal	105	125
	shale	125	140
WELL PURPOSE: home (home, irrigation, municipal, industrial)	fine sand & sandy shale	140	180
WELL COMPLETION DATA:	shale	180	198
(1) diameter (inches) 4"	Rock	198	201
(2) total depth (feet) 240'	fine sand	201	240
(3) static water level (feet) 40' below top of ground.			
(4) casing PVC, 130' (material) (depth) 4" if telescope see back. (size)			
(5) screen (length) (depth to top) (size) (material)			
(6) pump 1/2 8 gpm (HP) (yield/gpm) F (type power)			
(7) electric log (yes or no)			
(8) how well bottom plugged Open			

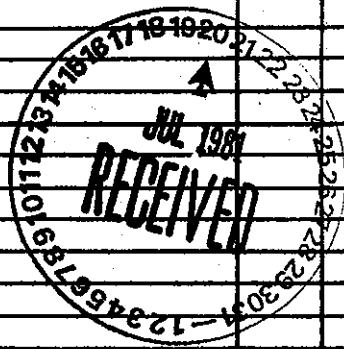

DRILLERS REMARKS: