

LAUD.

**WATER WELL DRILLERS LOG**

Date: 5-3-66, 1966, Driller: M. E. Donald & H. W. Co. Inc Landisdale County Landisdale

(Name)

(1) Owner of Land: Doby R. MATHEIS  
(Name)  
Rt 3 MDN  
(Address)

(2) Location: 1/4, 1/4, Sec. 16 T. R.  
ON ZERO ROAD.  
5 miles SE of Maiden  
(distance) (direction) (Nearest Town)

(3) Topography: HILLY  
(Hilly) (Flat) (Level)

(4) Purpose of Well: DOMESTIC  
(Domestic Irrigation  
Municipal, Industrial, Other)

Description & Color of Materials Sand, Clay, Red Clay, Shell, etc.	Thick- ness Feet	Depth Feet
CLAY	0	7
H Shale	7	90
Soft Shale	90	95
C Sand	95	105
Rock	105	108
Yellow Sand Rock	108	124
Rock	124	126
SHALE	126	144
White Sand + Aquifer	144	150
White Clay Soft	150	168
Soft Shale Greenish	168	196
Sandy Shale Light	196	220
Shale + Light	220	231
greasy Shale	231	245
M to H Shale	245	270
Soft to hard Shale	270	300
Rock	300	302
Shale	302	312
Rock	312	314
Shale	314	325
Rock	325	327
Shale + Sandstone	327	355
H Shale	355	364
Soft to hard Shale	364	369
Rock	369	373
Soft to hard Shale	373	380

Information upon completion of well:

(1) Diameter 4 inches.

(2) Total Depth 380 feet.

(3) Water Level 148 feet below top of ground.

(4) Cased to 268, Size \_\_\_\_\_


(5) Screen: Size \_\_\_\_\_, Length \_\_\_\_\_

(6) Were any formations sealed against pollution?  
\_\_\_\_\_ yes, \_\_\_\_\_ no.

If YES depth of formation \_\_\_\_\_

Why \_\_\_\_\_

Drillers Remarks: \_\_\_\_\_

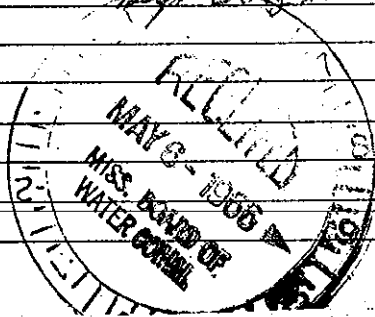

Well