

LAUD.

MISSISSIPPI BOARD OF WATER COMMISSIONERS

S 10

12-18-60

WATER WELL DRILLERS LOG

Date: 12-18, 1960, Driller: Hester Ogletree County, Neshoba
(Name)

(1) Owner of Land: <u>Robert Smith</u> (Name)	Description & Color of Materials Sand, Clay, Red Clay, Shell, etc.	Thick- ness Feet	Depth Feet
<u>Meridian, Miss.</u> (Address)	<u>Sand & Clay for 60 ft.</u>		
(2) Location: <u>1/4, 1/4, Sec. 17 T. R.</u> <u>4 miles South</u> of <u>Meridian</u> (distance) (direction) (Nearest Town)	<u>287 ft. blue clay, 30 ft. 9 with sand</u>		
(3) Topography: <input checked="" type="radio"/> (Hilly) <input type="radio"/> (Flat) <input type="radio"/> (Level)			
(4) Purpose of Well: <u>Home use</u> (Domestic Irrigation Municipal, Industrial, Other)			


Information upon completion of well:

- (1) Diameter 4 1/2 inches.
- (2) Total Depth 377 feet.
- (3) Water Level 130 feet below top of ground.
- (4) Cased to 189, Size 2 in.
- (5) Screen: Size _____, Length _____.
- (6) Were any formations sealed against pollution?
_____ yes, _____ no.

If YES depth of formation _____

Why _____

Drillers Remarks: _____

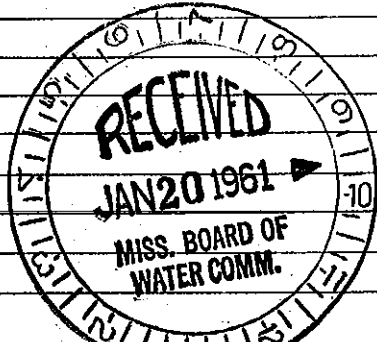

We