

LAUD.

S12

8-11-64

WATER WELL DRILLERS LOG

Date: 8/11, 1964, Driller: Bob Williams, County Lauderdale

(Name)

(1) Owner of Land: Robert Rutledge
 (Name)
Meridian, Miss. High 45-5
 (Address)

(2) Location: 1/4, 1/4, Sec. 19 T. R,
5 miles South, of Meridian
 (distance) (direction) (Nearest Town)

(3) Topography: hilly
 (Hilly) (Flat) (Level)

(4) Purpose of Well: domestic
 (Domestic Irrigation
 Municipal, Industrial, Other)

Description & Color of Materials Sand, Clay, Red Clay, Shell, etc.	Thick- ness Feet	Depth Feet
<u>red sand</u>	<u>30</u>	<u>1-20</u>
<u>white sand</u>	<u>30</u>	<u>90-50</u>
<u>stopped on rock</u>		


Information upon completion of well:

- (1) Diameter 2 inches.
- (2) Total Depth 50 feet.
- (3) Water Level 38 feet below top of ground.
- (4) Cased to 45, Size 2"
- (5) Screen: Size 2", Length 4"
- (6) Were any formations sealed against pollution?
 yes, no.

If YES depth of formation _____

Why _____

Drillers Remarks: _____

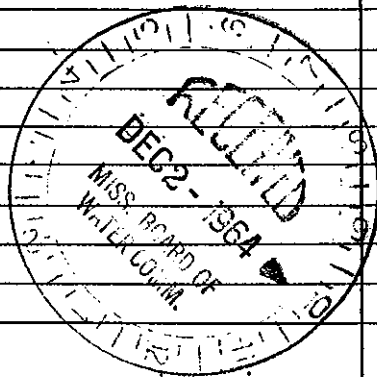

(Use Back Side)

Well No. _____

this copy for your office files.