

S 13

WATER WELL DRILLERS LOG

8-2-63

Date: 8-2, 1963, Driller: Mc Donald & Hill County Land -

(Name)

(1) Owner of Land: Patterson
 (Name)
Meridian, Route one
 (Address)

(2) Location: $\frac{1}{4}$, $\frac{1}{4}$, Sec. 19 T R
5 miles S, of Meridian
 (distance) (direction) (Nearest Town)

(3) Topography: Hilly
 (Hilly) (Flat) (Level)

(4) Purpose of Well: Domestic
 (Domestic Irrigation
 Municipal, Industrial, Other)

Description & Color of Materials Sand, Clay, Red Clay, Shell, etc.	Thick- ness Feet	Depth Feet
Clay	0	18
Sand	18	45
Shale	45	56
Silty shale & sand	56	65
Silty shale	65	140
Sand	140	195
Silty shale & sand	195	220
Shale	220	255
Sand - silty shale	255	262
Sand	262	270
Silty shale & lig.	270	285
Shale	285	318
Hard lime rock	318	320
Silty shale & lime	320	382
Shale	382	420
Shale w/ lime str.	420	490
Hard lime w/ str.	490	540
Sandstone	540	585
Fine blk. sil.	585	600
Hard lime	600	602
Sandstone	602	612
Sand & sandstone	612	665

Information upon completion of well:

(1) Diameter 3 7/8 inches.

(2) Total Depth 665 feet.

(3) Water Level 325 feet below top of ground.

(4) Cased to 431, Size 4"


(5) Screen: Size _____, Length _____

(6) Were any formations sealed against pollution?
 _____ yes, _____ no.

If YES depth of formation _____

Why _____

Drillers Remarks: _____

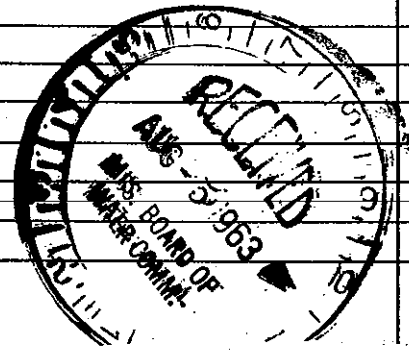

Well 1