



LAUD.
S 17

MISSISSIPPI BOARD OF WATER COMMISSIONERS

WATER WELL DRILLERS LOG

Date: 11-18, 1963, Driller: McDaniel & Hill County Lumberton
(Name)

(1) Owner of Land: <u>Jamie Higgins</u> (Name)	Description & Color of Materials Sand, Clay, Red Clay, Shell, etc.	Thick- ness Feet	Depth Feet
<u>Rt. #3</u> (Address)	Clay	0	7
(2) Location: <u>29</u> T <u>R</u>	Sd.	7	10
<u>7</u> miles <u>S</u> of <u>Murphy</u> (distance) (direction) (Nearest Town)	Clay	10	18
(3) Topography: <u>Hilly</u> (Hilly) (Flat) (Level)	Shell	18	30
(4) Purpose of Well: <u>Domestic</u> (Domestic Irrigation Municipal, Industrial, Other)	Fine shale	30	110
Information upon completion of well:	Sand	110	112
(1) Diameter <u>3 7/8</u> inches.	White Clay	112	118
(2) Total Depth <u>164</u> feet.	Coarse Sand	118	164
(3) Water Level <u>150</u> feet below top of ground.	Red from 140-150		
(4) Cased to <u>159</u> , Size <u>2"</u>			
(5) Screen: Size <u>2"</u> , Length <u>5"</u>			
(6) Were any formations sealed against pollution? _____ yes, _____ no.			
If YES depth of formation _____			
Why _____			
Drillers Remarks: _____			

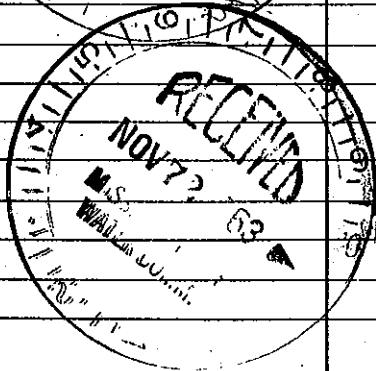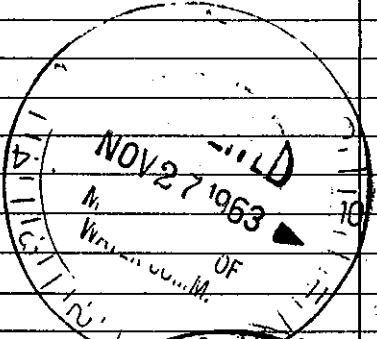

Well No. 132

(Use Back Side)

Mail this copy to Board of Water Commissioners 429 Miss. St. Jackson, Miss.