

LAUD.

MISSISSIPPI BOARD OF WATER COMMISSIONERS

S19

WATER WELL DRILLERS LOG

4-6-62

Date: 4.6, 1962, Driller: McDONALD, HILL County: LAUDERDALE

(Name)

(1) Owner of Land: BILL SIMS
(Name)
R# 3 MERIDIAN
(Address)

(2) Location: 1/4, 1/4, Sec. 25 T. R.
8 miles S. EAST of MERIDIAN
(distance) (direction) (Nearest Town)

(3) Topography: X
(Hilly) (Flat) (Level)

(4) Purpose of Well: DOMESTIC
(Domestic Irrigation, Municipal, Industrial, Other)

Description & Color of Materials Sand, Clay, Red Clay, Shell, etc.	Thick- ness Feet	Depth Feet
CLAY	0	10
SAND	10	32
SHALE	32	42
SAND CLAY	42	70
SHALE	70	105
SANDY SHALE	105	111
FINE SAND SANDY SHALE	111	170
SHALE	170	205
SAND	205	230
SANDY SHALE	230	254
ROCK	254	260
SHALE	260	360
SAND	360	370
SHALE	370	390
SANDY SHALE FINE SAND	390	440
FINE SAND	440	450

Information upon completion of well:

(1) Diameter: 4" inches.

(2) Total Depth: 450' feet.

(3) Water Level: 210' feet below top of ground.

(4) Cased to: 274', Size: 4"


(5) Screen: Size _____, Length _____.

(6) Were any formations sealed against pollution?
_____ yes, _____ no.

If YES depth of formation _____

Why _____

Drillers Remarks: _____

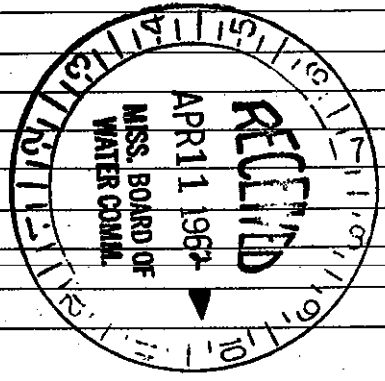

Well #