

no lat-long

LAUDERDALE  
520  
3-68

MISSISSIPPI  
BOARD OF WATER COMMISSIONERS  
416 North State Street  
Jackson, Mississippi 39201

WATER WELL DRILLERS LOG

3.18.68 19 McDONALD + HILL LAUDERDALE  
date well completed firm name county well located

LANDOWNER: WILLIAM MOORE  
LONG CREEK  
R# 3  
(mailing address)


WELL LOCATION:  
sec. 2 T. 5 N. R. 16 E.  
S. W.  
2 miles EAST of LONG CREEK  
(distance) (direction) (nearest town)

WELL PURPOSE: HOME  
(home, irrigation, municipal, industrial)

WELL COMPLETION DATA:

- (1) diameter (inches) 4" WELL
- (2) total depth (feet) 480'
- (3) static water level (feet) 205' below above top of ground.
- (4) casing BLACK, 273  
(material) (depth)  
4"  
(size) if telescope see back.
- (5) screen NO, NO  
(length) (depth to top)  
NO, NO  
(size) (material)
- (6) pump 34, 10  
(HP) (yield gpm)  
220  
(type power)
- (7) electric log NO  
(yes or no)  
NO  
(organization running log)
- (8) how well bottom plugged OPEN

description of formations encountered	from	to
Sand Clay	0	35
Sand Shale	35	38
Clay Lt. Sand	38	80
Sand	80	120
Shale Lt. Sand	120	170
Sand	170	195
Sandy Sh. Shale	195	220
Shale	220	300
Sandy Shale	300	340
Soft Shale	340	375
fine sand Lt. Shale	375	422
Sandy	422	480

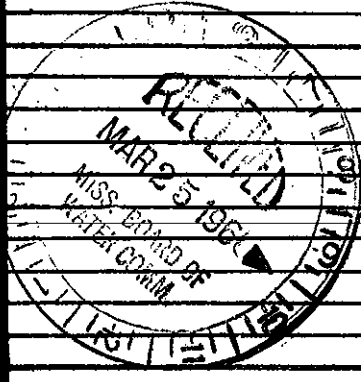

DRILLERS REMARKS: