

LAUDERDALE

528

7-14-67

MISSISSIPPI BOARD OF WATER COMMISSIONERS 416 North State Street Jackson, Mississippi 39201

CODED

WATER WELL DRILLERS LOG

7-14-67 date well completed

McDonald + Hill firm name

Underwood county well located

LANDOWNER: UNDERWOOD R#1 Meridian (mailing address)


WELL LOCATION: sec 4 T 50 S R 16 W 4 miles S.E. of Meridian (distance) (direction) (nearest town)

WELL PURPOSE: HOME (home, irrigation, municipal, industrial)

WELL COMPLETION DATA: (1) diameter (inches) 4" WELL (2) total depth (feet) 420' (3) static water level (feet) 175 below top of ground (4) casing BLK 283 (material) (depth) 14" (size) If telescope see back. (5) screen NO (length) NO (depth to top) NO (size) NO (material) (6) pump 1 hp (HP) 10 (yield gpm) 220 (type power) (7) electric log NO (yes or no) 12 (organization running log) (8) how well bottom plugged OPEN

Table with 3 columns: description of formations encountered, from, to. Rows include CLAY SHALE, YELLOW SAND, SAND ST CLAY SHALE, SOFT SHALE, SANDY SHALE, MED SHALE, ROCK, SANDY SHALE, ROCK, SANDY SHALE, ROCK, SHALE, ROCK, SOFT SANDY SHALE, ROCK, FINE SAND SANDY SHALE.

CODED

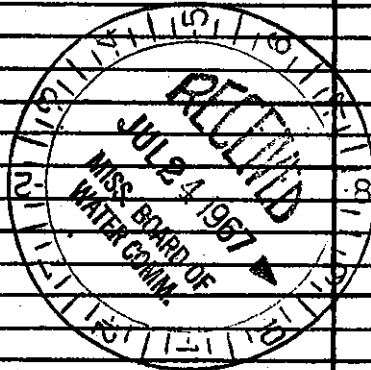

DRILLERS REMARKS: