

LAUDERDALE  
 529  
 3-68

MISSISSIPPI  
 BOARD OF WATER COMMISSIONERS  
 416 North State Street  
 Jackson, Mississippi 39201

**CODED**

WATER WELL DRILLERS LOG

3.5-68 19 McDonald + Hill LAUDERDALE  
 date well completed firm name county well located

LANDOWNER: JAMES WILSON  
 R#3 MERIDIAN  
 (mailing address)


WELL LOCATION:  
 sec. 2 T. 5 N. R. 16 E.  
 5 miles SOUTH MERIDIAN  
 (distance) (direction) (nearest town)

WELL PURPOSE: HOME  
 (home, irrigation, municipal, industrial)

- WELL COMPLETION DATA:
- (1) diameter (inches) 4" WELL
  - (2) total depth (feet) 420'
  - (3) static water level (feet) 225' below top of ground.
  - (4) casing Black (material), 273' (depth)  
 4" (size) If telescope see back.
  - (5) screen NO (length), NO (depth to top)  
 NO (size), NY (material)
  - (6) pump 34 (HP), 220 (yield gpm)  
 220 (type power)
  - (7) electric log NO (yes or no)  
 NO (organization running log)
  - (8) how well bottom plugged OPEN

description of formations encountered	from	to
Sandy Clay	0	11
Sand Rock	11	13
Sandy Lt Clay	13	60
Shale	60	120
Sand	120	190
Shale	190	210
Sandy	210	240
Shale	240	330
Sandy	330	345
Sandy Rock	345	349
Shale	349	375
Sand Sandy Shale	375	420

**CODED**

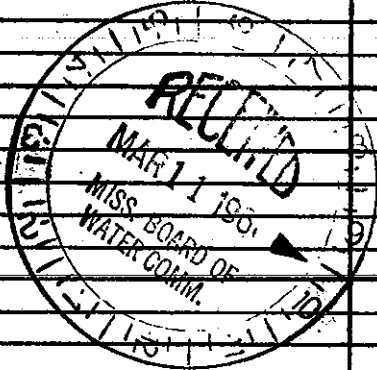

DRILLERS REMARKS: