

LAUD.
531
7-11-60

MISSISSIPPI BOARD OF WATER COMMISSIONERS

WATER WELL DRILLERS LOG

CODED

Date: 7-11, 1960, Driller: McDonald & Hill Inc County Lauderdale
(Name)


(1) Owner of Land: Eddie Lunnans
(Name)
R#1 Meridian
(Address)
(2) Location: 1/4, 4, 5 16 Sec. T R
2 miles south of Meridian
(distance) (direction) (Nearest Town)
(3) Topography: _____
(Hilly) (Flat) (Level)
(4) Purpose of Well: DOMESTIC
(Domestic Irrigation, Municipal, Industrial, Other)

Description & Color of Materials Sand, Clay, Red Clay, Shell, etc.	Thick- ness Feet	Depth Feet
<u>Clay</u>	<u>0</u>	<u>15</u>
<u>Sand</u>	<u>15</u>	<u>40</u>
<u>Shale</u>	<u>40</u>	<u>60</u>
<u>sandy shale</u>	<u>60</u>	<u>120</u>
<u>med shale</u>	<u>120</u>	<u>240</u>
<u>hardy shale</u>	<u>240</u>	<u>260</u>
<u>soft shale</u>	<u>260</u>	<u>340</u>
<u>fine sand</u>	<u>341</u>	<u>370</u>

Information upon completion of well:

(1) Diameter 3" inches.
(2) Total Depth 370 feet.
(3) Water Level 90 feet below top of ground.
(4) Cased to 210', Size 3"
(5) Screen: Size _____, Length _____
(6) Were any formations sealed against pollution?
_____ yes, no no.

CODED

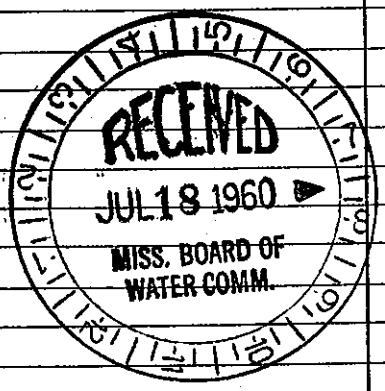

If YES depth of formation _____
Why _____
Drillers Remarks: _____

(Use Back Side)

Well No.

Mail this copy to Board of Water Commissioners 429 Miss. St. Jackson, Miss.