

L.A.U.O.

MISSISSIPPI BOARD OF WATER COMMISSIONERS

CODED


S 36
7-28-62

WATER WELL DRILLERS LOG

Date 7-28-62, 1962, Driller McDonald & Hill County Lauderdale
(Name)

(1) Owner of Land	Description & Color of Materials Sand, Clay, Red Clay, Shell, etc.	Thick- ness Feet	Depth Feet
<u>Security Bldg. Co.</u> (Name) <u>45 south - office Shields Bldg.</u> (Address)	Rock	0	4
(2) Location: $\frac{1}{4}$, $\frac{1}{4}$, Sec. <u>5</u> T. <u>16</u> R.	Clay	4	10
<u>4</u> miles <u>South</u> of <u>Meridian</u> (distance) (direction) (Nearest Town)	Shale	10	18
(3) Topography: (Hilly) (Flat) (Level)	Clay sand	18	26
(4) Purpose of Well: <u>Domestic</u> (Domestic Irrigation Municipal, Industrial, Other)	Rock	26	28
Information upon completion of well:	Rock	28	85
(1) Diameter <u>4</u> inches.	Clay st. sand	85	100
(2) Total Depth <u>650</u> feet.	Sand	100	190
(3) Water Level <u>375</u> feet below top of ground.	Clay st. sand	190	220
(4) Cased to <u>441</u> , Size <u>4"</u>	Shale	220	300
(5) Screen: Size _____, Length _____	Shale	300	500
(6) Were any formations sealed against pollution? _____ yes, _____ no.	Soft shale	500	550
If YES depth of formation _____	Shale st. sand	550	580
Why _____	Sandy shale	580	600
Drillers Remarks: _____	Sand	600	650

CODED

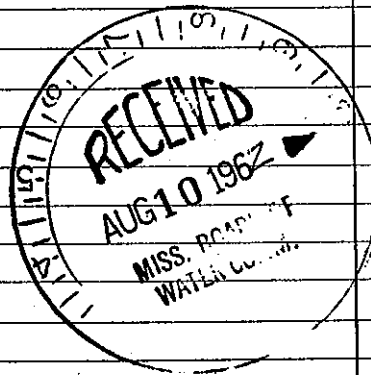

Well No.

(Use Back Side)

Mail this copy to Board of Water Commissioners 429 Miss. St. Jackson, Miss.