

LAUD.

MISSISSIPPI BOARD OF WATER COMMISSIONERS

S41

WATER WELL DRILLERS LOG

CODED

10-30-62

Date: 10-30, 1962, Driller: Mr. Donald - Hill County *Lauderdale*

(Name)

	Description & Color of Materials Sand, Clay, Red Clay, Shell, etc.	Thick- ness Feet	Depth Feet
(1) Owner of Land: <i>Jothell Smith</i>	<i>Clay</i>	0	20
(Name) _____	<i>Sandy Clay</i>	20	40
<i>2703-Prospect ave. Meridian</i>	<i>Sand fine</i>	40	80
(Address) _____	<i>Sand No 10</i>	12	92
(2) Location: _____, _____, Sec. <i>10 5 16</i>			
(distance) _____, _____, (Nearest Town) <i>Meridian</i>			
(3) Topography: <input checked="" type="checkbox"/> (Hilly) _____ (Flat) _____ (Level) _____			
(4) Purpose of Well: <i>Domestic</i> (Domestic Irrigation Municipal, Industrial, Other)			

CODED

Information upon completion of well:

(1) Diameter 2 inches.

(2) Total Depth 130 feet.

(3) Water Level 38 feet below top of ground.

(4) Cased to 126, Size 2"


(5) Screen: Size no 8, Length 3

(6) Were any formations sealed against pollution?
no yes, _____ no.

If YES depth of formation _____

Why _____

Drillers Remarks: _____

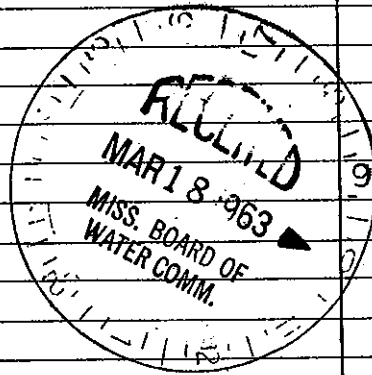

Well No. _____

(Use Back Side)

Mail this copy to Board of Water Commissioners 429 Miss. St. Jackson, Miss