

MISSISSIPPI BOARD OF WATER COMMISSIONERS

WATER WELL DRILLERS LOG

CODED

LAUD.

S42

2-12-63

Date: 2-12, 1963, Driller: McDONALD & HILL, INC. County: Lauderdale

(Name)

(1) Owner of Land:	Description & Color of Materials Sand, Clay, Red Clay, Shell, etc.	Thick- ness Feet	Depth Feet
<u>M. B. Alexander</u> (Name) <u>Rt #3 Meridian</u> (Address)	<u>Clay</u>	<u>0</u>	<u>62</u>
<u>26 S 16</u> (Address)	<u>Shale</u>	<u>62</u>	<u>108</u>
(2) Location: <u>1/4</u> , <u>1/4</u> , Sec. <u>5</u> T. <u>R.</u>	<u>Shale & sand</u>	<u>108</u>	<u>170</u>
<u>12</u> miles <u>SE</u> , of <u>Meridian</u> (distance) (direction) (Nearest Town)	<u>Sand</u>	<u>170</u>	<u>200</u>
(3) Topography: <input checked="" type="checkbox"/> (Hilly) <input type="checkbox"/> (Flat) <input type="checkbox"/> (Level)			
(4) Purpose of Well: <u>Domestic</u> (Domestic Irrigation, Municipal, Industrial, Other)			

CODED

Information upon completion of well:

(1) Diameter 2 inches.

(2) Total Depth 200 feet.

(3) Water Level 84 feet below top of ground.

(4) Cased to 195, Size 2.


(5) Screen: Size # 8, Length 3.

(6) Were any formations sealed against pollution?
 yes, no.

If YES depth of formation _____

Why _____

Drillers Remarks: _____

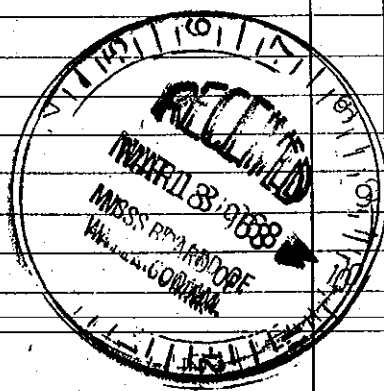

Well No.

(Use Back Side)

Retain this copy for your office files.