

CAUD.
543
3-25-63

WATER WELL DRILLERS LOG

CODED

Date: 3. 25., 1963, Driller McDonald Hill County Madison
(Name)

(1) Owner of Land	Description & Color of Materials Sand, Clay, Red Clay, Shell, etc.	Thick- ness Feet	Depth Feet
<u>VERNAL BUFFINGTON</u> (Name)	<u>CLAY</u>	<u>0</u>	<u>20</u>
<u>DUFFIE MISS</u> (Address)	<u>SHALE ST ROCK</u>	<u>20</u>	<u>88</u>
(2) Location: <u>19 5 16</u>	<u>YELLOW SAND CLAY</u>	<u>88</u>	<u>120</u>
<u>1/4</u> , <u>1/4</u> , Sec <u>T R</u>	<u>BLUE SHALE</u>	<u>120</u>	<u>220</u>
<u>18</u> miles <u>WEST</u> , of <u>MERIDIAN</u> (distance) (direction) (Nearest Town)	<u>FINE SAND</u>	<u>220</u>	<u>260</u>
(3) Topography: <u>X</u>			
(Hilly) (Flat) (Level)			
(4) Purpose of Well: <u>DOMESTIC</u>			
(Domestic Irrigation Municipal, Industrial, Other)			

CODED

Information upon completion of well:

(1) Diameter 3" inches.

(2) Total Depth 260 feet.

(3) Water Level 148' feet below top of ground.

(4) Cased to 190', Size 3"


(5) Screen: Size _____, Length _____

(6) Were any formations sealed against pollution?
_____ yes, _____ no.

If YES depth of formation _____

Why _____

Drillers Remarks: _____

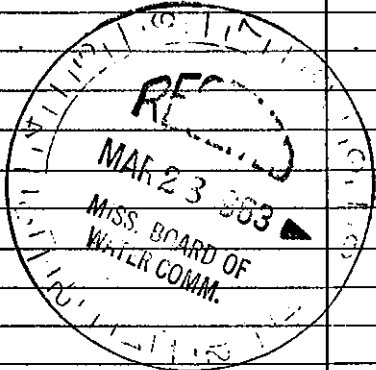

(Use Back Side)

Well No.

Mail this copy to Board of Water Commissioners 429 Miss. St. Jackson, Miss.