

LAUD. MISSISSIPPI BOARD OF WATER COMMISSIONERS

545
6-20-63

WATER WELL DRILLERS LOG **CODED**

Date: 6-20, 1963, Driller: Mr. Donald & Will County: Tandubale
(Name)


(1) Owner of Land: Louis J. Medina
(Name)
Rt. #1, Mendon, Miss
(Address)
(2) Location: 1/4, 1/4, Sec. 5 T. 16
7 miles South of Mendon
(distance) (direction) (Nearest Town)
(3) Topography: Hilly
(Hilly) (Flat) (Level)
(4) Purpose of Well: Domestic
(Domestic Irrigation, Municipal, Industrial, Other)

Description & Color of Materials Sand, Clay, Red Clay, Shell, etc.	Thick- ness Feet	Depth Feet
<u>slaty clay</u>	<u>0</u>	<u>4</u>
<u>sand</u>	<u>4</u>	<u>20</u>
<u>sand & clay</u>	<u>20</u>	<u>50</u>
<u>shale</u>	<u>50</u>	<u>65</u>
<u>shale w/ lime st.</u>	<u>65</u>	<u>130</u>
<u>limestone</u>	<u>130</u>	<u>220</u>
<u>shale</u>	<u>225</u>	<u>290</u>
<u>limestone & shale</u>	<u>290</u>	<u>350</u>
<u>shale w/ lime st.</u>	<u>350</u>	<u>365</u>
<u>sandy lime & dol.</u>	<u>365</u>	<u>374</u>
<u>shale w/ lime st.</u>	<u>374</u>	<u>390</u>
<u>shale w/ some lime</u>	<u>390</u>	<u>420</u>
<u>slaty, shale</u>	<u>420</u>	<u>470</u>
<u>sl & slaty shale</u>	<u>470</u>	<u>490</u>
<u>slaty, shale & shale</u>	<u>490</u>	<u>510</u>
<u>shale & hard lime</u>	<u>510</u>	<u>575</u>
<u>shale & lignite</u>	<u>575</u>	<u>585</u>
<u>shale & hard lime</u>	<u>585</u>	<u>720</u>
<u>slaty, shale & dol.</u>	<u>720</u>	<u>750</u>
<u>shale</u>	<u>750</u>	<u>770</u>
<u>slaty, shale</u>	<u>770</u>	<u>790</u>

Information upon completion of well:

(1) Diameter: 3 3/8 inches.
(2) Total Depth: 790 feet.
(3) Water Level: 290 feet below top of ground.
(4) Cased to: 419, Size 4"
(5) Screen: Size _____, Length _____
(6) Were any formations sealed against pollution?
_____ yes, _____ no.

If YES depth of formation _____
Why _____
Drillers Remarks: _____

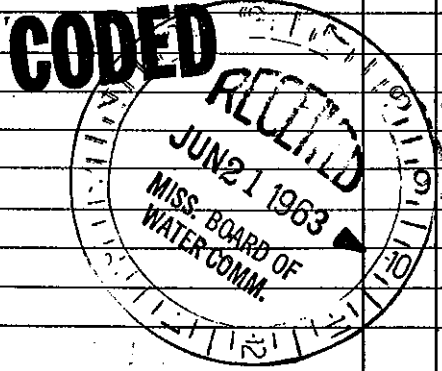

(Use Back Side)

Well No.

Mail this copy to Board of Water Commissioners 429 Miss. St. Jackson, Miss.