

547  
12-20-63

WATER WELL DRILLERS LOG


**CODED**

Date: 12-20, 1963, Driller: Mc. Donnell & Hill County Land & Lease

(Name)

(1) Owner of Land: <u>Bene Skinner</u> (Name)	Description & Color of Materials Sand, Clay, Red Clay, Shell, etc.	Thick- ness Feet	Depth Feet
<u>Route one, Meridian</u> (Address)	Clay	0	21
(2) Location: <u>1/4</u> , <u>5 1/4</u> Sec. <u>5 1/4</u> T. <u>R</u>	Sand	21	26
<u>5</u> miles <u>S</u> of <u>Meridian</u> (distance) (direction) (Nearest Town)	shale	20	35
(3) Topography: <u>Hilly</u> (Hilly) (Flat) (Level)	limy shale	35	110
(4) Purpose of Well: <u>Domestic</u> (Domestic Irrigation Municipal, Industrial, Other)	sandy shale	110	115
Information upon completion of well:	Sand	115	160
(1) Diameter <u>3 1/8</u> inches.	yellow clay	160	168
(2) Total Depth <u>380</u> feet.	sandy shale	168	172
(3) Water Level <u>231</u> feet below top of ground.	Sand	172	182
(4) Cased to <u>295</u> , Size <u>4</u>	sandy shale	182	200
(5) Screen: Size _____, Length _____	shale	200	233
(6) Were any formations sealed against pollution? _____ yes, _____ no.	Sand - sandy shale	233	243
If YES depth of formation _____	shale w/ some lignite	243	260
Why _____	sandy shale w/ some sdy	260	270
Drillers Remarks: _____	shale - some sdy shale	270	285
	shale	285	300
	shale w/ sdy shale	300	340
	sandy shale	340	345
	Sand	345	375
	sandy shale	375	380

**CODED**

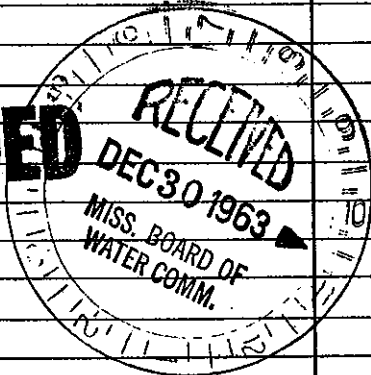

Well No.  
148

(Use Back Side)