

Lauderdale
 S 2000
 12-10-75

MISSISSIPPI
 BOARD OF WATER COMMISSIONERS
 416 North State Street
 Jackson, Mississippi 39201

WATER WELL DRILLERS LOG

12-10-75 1975 McDonald & Hill Inc Lauderdale
 date well completed firm name county well located

LANDOWNER: Germain Hilling

RTH 1

Meridian, Miss
 (mailing address)

WELL LOCATION:

sec. 4 T 5 N R 16 E

6 miles South Meridian
 (distance) (direction) of (nearest town)

WELL PURPOSE: home
 (home, irrigation, municipal, industrial)


WELL COMPLETION DATA:

- (1) diameter (inches) 4"
- (2) total depth (feet) 450
- (3) static water level (feet) 185 below above top of ground.
- (4) casing 4" PVC 267' (material) (depth)
 (size) if telescope see back.
- (5) screen (length) (depth to top)
 (size) (material)
- (6) pump 2HP (HP) (yield gpm)
 (type power)
- (7) electric log (yes or no)
 (organization running log)
- (8) how well bottom plugged open

description of formations encountered

description of formations encountered	from	to
Clay & shale	12	38
Shale	38	154
ST sand	158	182
shale	182	200
sandy	200	235
shale	235	255
ST sandy shale	255	263
Shale	263	380
ST sandy shale	380	450

DRILLERS REMARKS: None

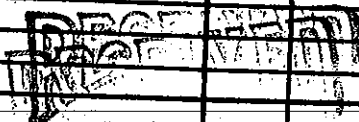

DEC 22 1975

MISS. BD. OF WATER COMM.