

WATER WELL DRILLERS LOG

L.A.U.

T1

9-4-61

Lauderdale


Date: 9-4, 1961, Driller: Peoples & Butledge county ~~Chadler~~
(Name)

(1) Owner of Land:	Description & Color of Materials Sand, Clay, Red Clay, Shell, etc.	Thick- ness Feet	Depth Feet
<u>W F Thomas Jr</u> (Name)	<u>Yellow Sandy Clay</u>		
<u>Lauderdale County</u> (Address)	<u>1/2 sand & shells</u>	<u>140</u>	<u>140</u>
(2) Location: <u>1/4, 1/4, Sec 29 T5R7</u>	<u>Gray sandy shale</u>	<u>30</u>	<u>170</u>
<u>_____</u> miles <u>_____</u> of <u>_____</u> (distance) (direction) (Nearest Town)	<u>Lignite</u>	<u>10</u>	<u>180</u>
(3) Topography: <u>Hilly</u> (Hilly) (Flat) (Level)	<u>Gray sandy shale lignite</u>	<u>80</u>	<u>260</u>
(4) Purpose of Well: <u>Domestic</u> (Domestic Irrigation Municipal, Industrial; Other)	<u>streaks</u>		
	<u>Gray sandy shale w/</u>		
	<u>small shell breaks</u>	<u>92</u>	<u>352</u>
	<u>Rock</u>	<u>3</u>	<u>355</u>
	<u>Sandy shale</u>	<u>7</u>	<u>362</u>
	<u>Rock</u>	<u>2</u>	<u>364</u>
	<u>Gray sandy shale</u>	<u>11</u>	<u>375</u>
	<u>Rock</u>	<u>2</u>	<u>377</u>
	<u>Fine gray sand w/</u>	<u>17</u>	<u>394</u>
	<u>shale streaks</u>	<u>86</u>	<u>480</u>
	<u>Gray sandy shale</u>		
	<u>Rock</u>	<u>4</u>	<u>484</u>
	<u>Gray sandy shale</u>	<u>26</u>	<u>510</u>

Information upon completion of well:

- (1) Diameter 4 inches.
- (2) Total Depth 510 feet.
- (3) Water Level 110 feet below top of ground.
- (4) Cased to 223, Size 4"
- (5) Screen: Size _____, Length _____
- (6) Were any formations sealed against pollution?
_____ yes, _____ no.

If YES depth of formation _____
Why _____
Drillers Remarks: _____

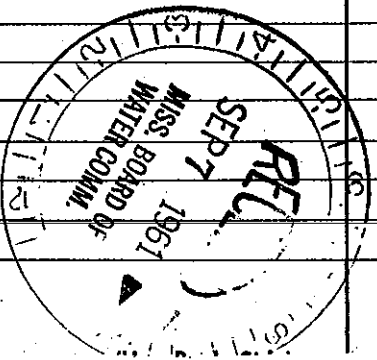

Well N