

L.A.U.O.

#T4

MISSISSIPPI BOARD OF WATER COMMISSIONERS

11-27-64

WATER WELL DRILLERS LOG

Date: 11-27, 1964, Driller: Bob Williams County Lauderdale
(Name)

(1) Owner of Land: B.M. clay
(Name)
Route #3 Meridian
(Address)

(2) Location: 1/4, 1/4, Sec. 5 T R
7 miles East of Meridian
(distance) (direction) (Nearest Town)

(3) Topography: hilly
(Hilly) (Flat) (Level)

(4) Purpose of Well: domestic
(Domestic Irrigation
Municipal, Industrial, Other)

Description & Color of Materials Sand, Clay, Red Clay, Shell, etc.	Thick- ness Feet	Depth Feet
<u>Red sand</u>	<u>10</u>	<u>1-10</u>
<u>White sand</u>	<u>10</u>	<u>10-20</u>
<u>blue clay</u>	<u>65</u>	<u>20-85</u>
<u>gray sand</u>	<u>43</u>	<u>85-128</u>


Information upon completion of well:

- (1) Diameter 2 inches.
- (2) Total Depth 128 feet.
- (3) Water Level 37 feet below top of ground.
- (4) Cased to 80, Size 2"
- (5) Screen: Size 0, Length _____
- (6) Were any formations sealed against pollution?
 yes, no.

If YES depth of formation _____

Why surface water

Drillers Remarks: _____

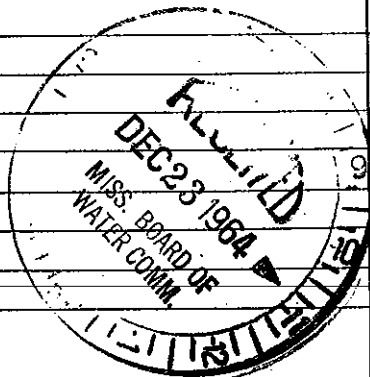

Well No. _____

(Use Back Side)