

LAUD.

MISSISSIPPI BOARD OF WATER COMMISSIONERS

ATS

WATER WELL DRILLERS LOG

10-18-61

Date: 10.18, 1961, Driller: McDonald Hill County LAUDERDALE (Name)

(1) Owner of Land	Description & Color of Materials Sand, Clay, Red Clay, Shell, etc.	Thick- ness Feet	Depth Feet
JOHNNIE ROBINSON (Name)	CLAY	0	10
MERIDIAN R# 7 (Address)	SAND CLAY	10	30
(2) Location: 1/4, 1/4, Sec. 9 T. R.	SAND	30	118
8 miles S. EAST of MERIDIAN (distance) (direction) (Nearest Town)	SANDY LINE	118	145
(3) Topography: X (Hilly) (Flat) (Level)	MED SHALE	145	192
(4) Purpose of Well: DOMESTIC (Domestic Irrigation Municipal, Industrial, Other)	SAND	192	215
	SAND No 14	215	235


Information upon completion of well:

- (1) Diameter: 5 1/2" inches.
- (2) Total Depth: 230' feet.
- (3) Water Level: _____ feet below top of ground.
- (4) Cased to: 189', Size: 4"
- (5) Screen: Size: 2", Length: 6'
- (6) Were any formations sealed against pollution?
_____ yes, _____ no.

If YES depth of formation _____

Why _____

Drillers Remarks: _____

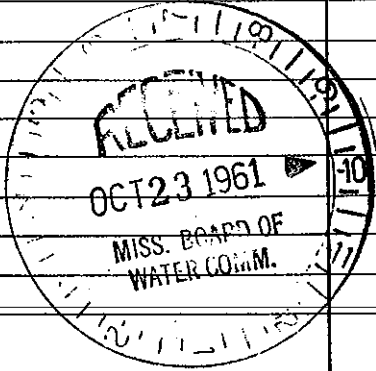

(Use Back Side)

Well No.

Mail this copy to Board of Water Commissioners 429 Miss. St. Jackson, Miss