

MISSISSIPPI BOARD OF WATER COMMISSION

WATER WELL DRILLERS LOG

LAUD.

OT6

2-27-64

Date: 2-27, 1964, Driller: Jerry County Laud

(Name)

(1) Owner of Land Mrs Baker
(Name)
Vinville, Miss.
(Address)

(2) Location: 1/4, 1/4, Sec. 1 T. R.
10 miles EAST of MDN
(distance) (direction) (Nearest Town)

(3) Topography: _____
(Hilly) (Flat) (Level)

(4) Purpose of Well: Domestic
(Domestic Irrigation
Municipal, Industrial, Other)

Description & Color of Materials Sand, Clay, Red Clay, Shell, etc.	Thick- ness Feet	Depth Feet
<u>yellow clay</u>	<u>0</u>	<u>25</u>
<u>Sandy Shale + Sand</u>	<u>25</u>	<u>125</u>
<u>hard formation</u>	<u>125</u>	<u>300</u>
<u>Sandy</u>	<u>300</u>	<u>320</u>

Information upon completion of well:

(1) Diameter 4 inches.

(2) Total Depth 320 feet.

(3) Water Level 150' feet below top of ground.

(4) Cased to 163', Size 4"


(5) Screen: Size NO, Length _____

(6) Were any formations sealed against pollution?
 yes, _____ no.

If YES depth of formation Soft + Sandy

Why to 125'

Drillers Remarks: Casing set in very hard formation

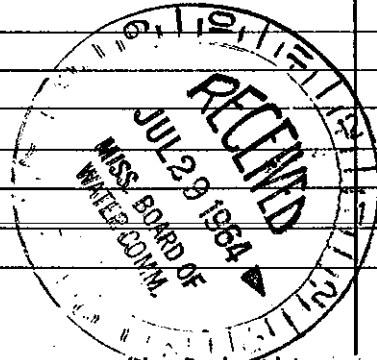

Well