

LAUD.

BOARD OF WATER COMMISSIONERS

WATER WELL DRILLERS LOG

6-26-64

Date: 6-26, 1964, Driller: Terry County: Laud

(1) Owner of Land: Boy Scouts of America
 (Name)
Vernonville, Miss.
 (Address)

(2) Location: 1/4, 1/4, Sec. 19 T. R.
15 miles EAST of MdN
 (distance) (direction) (Nearest Town)

(3) Topography: _____
 (Hilly) (Flat) (Level)

(4) Purpose of Well: Domestic & irrigation
 (Domestic Irrigation
 Municipal, Industrial, Other)

Description & Color of Materials Sand, Clay, Red Clay, Shell, etc.	Thick- ness Feet	Depth Feet
<u>Soft formation</u>	<u>0</u>	<u>490'</u>
<u>Sandy Shale</u>	<u>490</u>	<u>550'</u>
<u>Good sand</u>	<u>550</u>	<u>594'</u>

Information upon completion of well:

(1) Diameter 5 1/2 inches.

(2) Total Depth 594 feet.

(3) Water Level 300' feet below top of ground.

(4) Cased to 494', Size 5 1/2


(5) Screen: Size 2 1/2", Length 30'

(6) Were any formations sealed against pollution?
 yes, _____ no.

If YES depth of formation 494

Why Soft - low water level

Drillers Remarks: _____

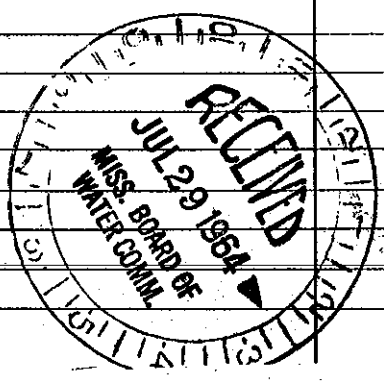

We