

LAUD.

MISSISSIPPI BOARD OF WATER WELL DRILLERS

S T 10
3-19-62

WATER WELL DRILLERS LOG

Date: 3.19, 1962, Driller: McDonald Hill County LAUDERDALE

(Name)

(1) Owner of Land: R.C. MALOTTE
(Name)

R# 3 MERIDIAN
(Address)

(2) Location: 1/4, 1/4, Sec. 35 T R

12 miles SEAST of MERIDIAN
(distance) (direction) (Nearest Town)

(3) Topography: X
(Hilly) (Flat) (Level)

(4) Purpose of Well: DOMESTIC
(Domestic Irrigation, Municipal, Industrial, Other)

Description & Color of Materials
Sand, Clay, Red Clay, Shell, etc.

Thick-
ness
Feet

Depth
Feet

CLAY	0	10
SAND	10	20
SHALE	20	26
SAND	26	36
SHALE	36	65
SANDY SHALE	65	80
FINE SAND	80	90
SHALE ST LIGNITE	90	190
SHALE	190	208
SANDY SHALE	208	256
SHALE	256	235
SAND	235	260

Information upon completion of well:

(1) Diameter 3" inches.

(2) Total Depth 350' feet.

(3) Water Level 92' feet below top of ground.

(4) Cased to 205', Size 3"


(5) Screen: Size _____, Length _____.

(6) Were any formations sealed against pollution?
_____ yes, _____ no.

If YES depth of formation _____.

Why _____.

Drillers Remarks: _____

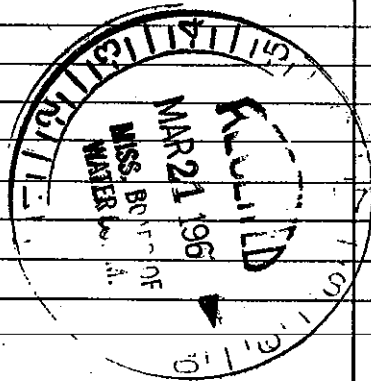

Well N