

LAUD.

T 11

11-27-65

WATER WELL DRILLERS LOG

Date: 11/27, 1965, Driller: TERRY County LAUD

(1) Owner of Land: BETHANY BAPTIST
 (Name)
Rt 7, MERIDIAN, Miss
 (Address)

(2) Location: 1/4, 1/4, Sec. 1 T R
10 miles EAST, of MdN.
 (distance) (direction) (Nearest Town)

(3) Topography: (Hilly) (Flat) (Level)

(4) Purpose of Well: DOMESTIC
 (Domestic Irrigation
 Municipal, Industrial, Other)

Description & Color of Materials (and by Red Clay, Shell, etc.)	Thick- ness Feet	Depth Feet
<u>YELLOW CLAY & SAND</u>	<u>0</u>	<u>24'</u>
<u>Blue clay & shale</u>	<u>24</u>	<u>210'</u>
<u>SANDY SHALE</u>	<u>210</u>	<u>260'</u>
<u>BLUE dirt</u>	<u>260</u>	<u>412</u>
<u>SANDY STREAKS - FINE</u>	<u>412</u>	<u>545</u>
<u>SOFT BLUE dirt</u>	<u>545</u>	<u>675</u>
<u>SAND - COARSE</u>	<u>675</u>	<u>712</u>

Information upon completion of well:

(1) Diameter 4 inches.

(2) Total Depth 712 feet.

(3) Water Level 286' feet below top of ground.

(4) Cased to 386', Size 4"


(5) Screen: Size 2", Length 20'

(6) Were any formations sealed against pollution?
 _____ yes, _____ no.

If YES depth of formation _____

Why _____

Drillers Remarks: Good WATER

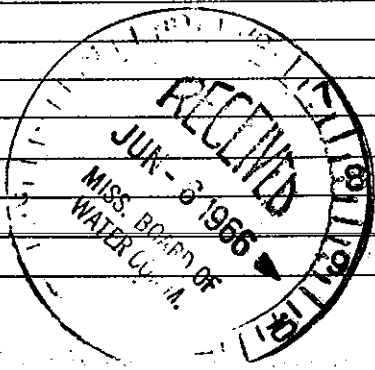

Well