

**LAVO. MISSISSIPPI BOARD OF WATER COMMISSIONERS**

**T13 WATER WELL DRILLERS LOG**

Date: 2-23, 1965, Driller: McDONALD & Hill, Inc. County: Prekeridge  
 (Name)

(1) Owner of Land: Jackie Feby  
 (Name)  
Rt # 7 Meridian, Miss.  
 (Address)

(2) Location: 1/4, 1/4, Sec. 1 T. R.  
10 miles E of Meridian  
 (distance) (direction) (Nearest Town)

(3) Topography:  (Hilly)  (Flat)  (Level)

(4) Purpose of Well: Domestic  
 (Domestic Irrigation, Municipal, Industrial, Other)

Description & Color of Materials Sand, Clay, Red Clay, Shell, etc.	Thick- ness Feet	Depth Feet
clay	0	7
sand	7	60
shale	60	75
sandy	75	81
rock	81	83
shale & soft rock	83	105
sandy	105	110
shale	110	140
sandy	140	160
rock	160	162
shale	162	170
sandy	170	180
shale	180	275
fine sand	275	300
sandy shale	300	360

Information upon completion of well:

(1) Diameter 4 inches.

(2) Total Depth 360 feet.

(3) Water Level 124 feet below top of ground.

(4) Cased to 190, Size 4"


(5) Screen: Size 20, Length \_\_\_\_\_

(6) Were any formations sealed against pollution?  
 \_\_\_\_\_ yes,  no.

If YES depth of formation \_\_\_\_\_

Why \_\_\_\_\_

Drillers Remarks: \_\_\_\_\_

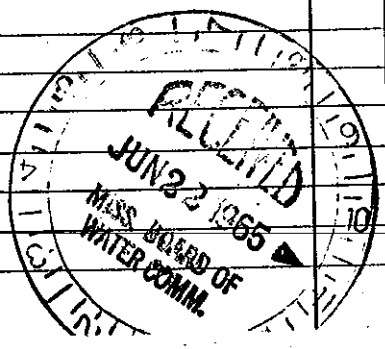

Well