

LAUD.  
T 14

MISSISSIPPI BOARD OF WATER COMMISSIONERS

WATER WELL DRILLERS LOG

5-14-65

Date: 5-14, 1965, Driller: McDonald & Hill, Inc. County: Audubon

(1) Owner of Land: J.D. Shieley  
 (Name)  
 Rf # 7, Meridian, Miss.  
 (Address)

(2) Location: 1/4, 1/4, Sec. 1 T R  
 10 miles SE of Meridian  
 (distance) (direction) (Nearest Town)

(3) Topography:  (Hilly)  (Flat)  (Level)

(4) Purpose of Well: Domestic  
 (Domestic Irrigation, Municipal, Industrial, Other)

Description & Color of Materials Sand, Clay, Red Clay, Shell, etc.	Thick- ness Feet	Depth Feet
Clay	0	20
Sandy clay	20	30
fine sand	30	80
fin sand	80	90
Shale	90	134
Gravel	134	138
Rock	138	142

Information upon completion of well:

(1) Diameter 2 inches.

(2) Total Depth 140 feet.

(3) Water Level 57 feet below top of ground.

(4) Cased to 133, Size 2"


(5) Screen: Size 2", Length 4 ft.

(6) Were any formations sealed against pollution?  
 yes,  no.

If YES depth of formation \_\_\_\_\_

Why \_\_\_\_\_

Drillers Remarks: \_\_\_\_\_

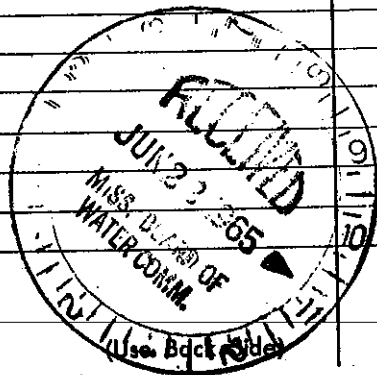

Well No.

Mail this copy to Board of Water Commissioners 429 Miss. St. Jackson, Miss.