


LAUD. MISSISSIPPI BOARD OF WATER COMMISSIONERS

T 15
4-23-64

WATER WELL DRILLERS LOG

Date: 4-23, 1964, Driller: W. P. Davis Hill APR 23
(Name)

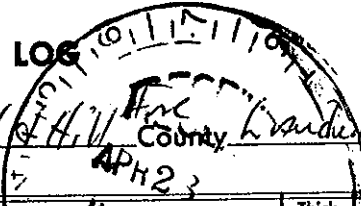

(1) Owner of Land:	Description & Color of Materials Sand, Clay, Red Clay, Shell, etc.	Thick- ness Feet	Depth Feet
<u>POPULAR SPRINGS BAPTIST</u>	<u>SAND</u>	<u>0</u>	<u>60</u>
<u>CHURCH</u>	<u>ROCK ST. SHALE</u>	<u>60</u>	<u>220</u>
<u>RT #1, Enterprise, Miss.</u>	<u>SAND</u>	<u>220</u>	<u>265</u>
(2) Location: <u>1/4</u> , <u>1/4</u> , Sec. <u>1 T R</u>	<u>SHALE</u>	<u>265</u>	<u>285</u>
<u>10</u> miles <u>S.E.</u> of <u>Meridian</u>	<u>SOFT SANDY</u>	<u>285</u>	<u>320</u>
<u>X</u> (Hilly) (Flat) (Level)	<u>SHALE ST. ILGONITE</u>	<u>320</u>	<u>340</u>
(3) Purpose of Well: <u>DOMESTIC</u>	<u>SHALE</u>	<u>340</u>	<u>370</u>
<small>(Domestic Irrigation Municipal, Industrial, Other)</small>	<u>SANDY</u>	<u>370</u>	<u>390</u>
	<u>SAND</u>	<u>370</u>	<u>420</u>

Information upon completion of well:

- (1) Diameter 4" inches.
- (2) Total Depth 420' feet.
- (3) Water Level 195' feet below top of ground.
- (4) Cased to 350', Size 4"
- (5) Screen: Size _____, Length _____
- (6) Were any formations sealed against pollution?
 _____ yes, _____ no.
- If YES depth of formation _____
- Why _____

Drillers Remarks: _____

Well