

LAUDERDALE
 T29
 3-68

MISSISSIPPI
 BOARD OF WATER COMMISSIONERS
 416 North State Street
 Jackson, Mississippi 39201

CODED

WATER WELL DRILLERS LOG

3.13.68 date well completed
 McDonald + Mill firm name
 LAUDERDALE county well located

LANDOWNER: GEORGE MINOR
Why NOT MISS
Rt #7
McLindian miss
 (mailing address)

WELL LOCATION:
 sec. 13 T. 5 N. R. 17 E.
2 miles WEST of Why NOT
 (distance) (direction) (nearest town)


WELL PURPOSE: HOME
 (home, irrigation, municipal, industrial)

WELL COMPLETION DATA:

- (1) diameter (inches) 4" WELL
- (2) total depth (feet) 570'
- (3) static water level (feet) 315 below top of ground.
- (4) casing BLACK 357'
 (material) (depth)
4"
 (size) If telescope see back.
- (5) screen NO NO
 (length) (depth to top)
NO NO
 (size) (material)
- (6) pump 1HP 10
 (HP) (yield gpm)
220'
 (type power)
- (7) electric log NO
 (yes or no)
NO
 (organization running log)
- (8) how well bottom plugged OPEN

description of formations encountered	from	to
SAND	0	45
SAND ROCK	45	46
SAND	46	68
CLAY	68	110
SAND	110	160
Shale	160	200
ROCK	200	201
SANDY ST SHELLS	201	212
SHALE	212	260
ROCK	260	268
SHALE	268	400
SANDY	400	417
SHALE	417	505
SAND ST SHALE	505	535
SANDY ST SHALE	535	570

CODED

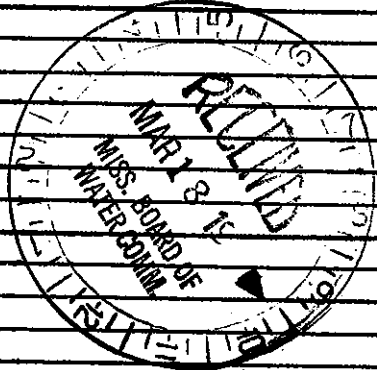

DRILLERS REMARKS:

Over