

L.A.U.D.
T 36
12-29-60

BOARD OF WATER COMMISSIONERS

WATER WELL DRILLERS LOG

CODED

Date: 12-29-60, 1960, Driller: McDonald Hill County Lambert

(Name)


(1) Owner of Land: S. L. Wilson
(Name)
R# 4 Meridian
(Address)
(2) Location: 1/4, 1 1/4, Sec. 5 17
T. R.
1 1/4 miles East of Meridian,
(distance) (direction) (Nearest Town)
(3) Topography: X
(Hilly) (Flat) (Level)
(4) Purpose of Well: Domestic
(Domestic Irrigation
Municipal, Industrial, Other)

Description & Color of Materials Sand, Clay, Red Clay, Shell, etc.	Thick- ness Feet	Depth Feet
<u>Clay</u>	<u>0</u>	<u>12</u>
<u>Sandy Clay</u>	<u>12</u>	<u>60</u>
<u>Loft Clay</u>	<u>60</u>	<u>125</u>
<u>Sand</u>	<u>125</u>	<u>132</u>
<u>Shale</u>	<u>132</u>	<u>160</u>
<u>Loft Greasy Shale</u>	<u>160</u>	<u>230</u>
<u>Med Shale</u>	<u>230</u>	<u>270</u>
<u>Sandy Shale</u>	<u>270</u>	<u>295</u>
<u>fine sand</u>	<u>295</u>	<u>330</u>

Information upon completion of well:

(1) Diameter 3" inches.
(2) Total Depth 330' feet.
(3) Water Level 195' feet below top of ground.
(4) Cased to 245', Size 3"
(5) Screen: Size _____, Length _____
(6) Were any formations sealed against pollution?
_____ yes, X no.

CODED

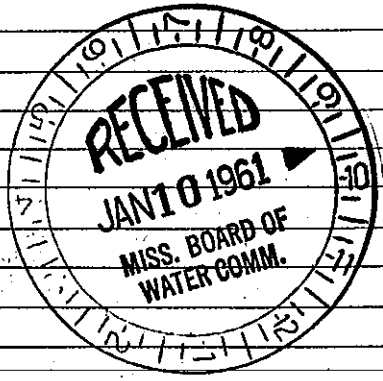

If YES depth of formation _____
Why _____
Drillers Remarks: _____

(Use Back Side)

Well No.

Mail this copy to Board of Water Commissioners 429 Miss. St. Jackson, Miss