

LAND.
37
6-8-61

WATER WELL DRILLERS LOG

2
CODED

Date: 6-8, 1961, Driller: McDonald + Hill County, Mississippi

(Name)

(1) Owner of Land: Bobby ENZOR
(Name)
Rt. #3 Meridian
(Address)

(2) Location: 1/4, 7 Sec. 5 T. 17 R.
10 miles South East of Meridian
(distance) (direction) (Nearest Town)

(3) Topography: (Hilly) (Flat) (Level)

(4) Purpose of Well: Domestic
(Domestic Irrigation, Municipal, Industrial, Other)

Description & Color of Materials Sand, Clay, Red Clay, Shell, etc.	Thick- ness Feet	Depth Feet
Clay	0	10
SOFT CLAY	10	30
Mucky Clay	30	95
SOFT SHALE	95	150
Fine Clay	150	167
Shale	167	183
Rock	183	185
Shale	185	195
Rock	195	197
Shale	197	300
Sandy Shale	300	330
Fine Sand	330	350

Information upon completion of well:

(1) Diameter 3 inches.

(2) Total Depth 350 feet.


(3) Water Level 195 feet below top of ground.

(4) Cased to 189, Size 3"

(5) Screen: Size _____, Length _____.

(6) Were any formations sealed against pollution?
_____ yes, no.

CODED

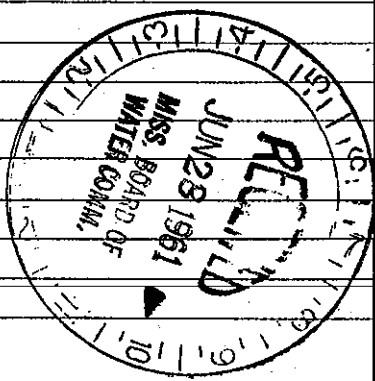

If YES depth of formation _____

Why _____

Drillers Remarks: _____

Well No.

(Use Back Side)