

LAUD.

MISSISSIPPI BOARD OF WATER COMMISSIONERS

T 38

WATER WELL DRILLERS LOG

CODED

9-8-61

Date: 9-8-61, 19 Driller: McDonald Hill County LAUDERDALE

(Name)

(1) Owner of Land: HERMAN BUNYARD  
 (Name)  
 MERIDIAN #7  
 (Address)

(2) Location: 1/4, 1/4, Sec. 8 5 17 T R  
 8 miles EAST, MERIDIAN  
 (distance) (direction) (Nearest Town)

(3) Topography: X  
 (Hilly) (Flat) (Level)

(4) Purpose of Well: DOMESTIC  
 (Domestic Irrigation  
 Municipal, Industrial, Other)

Description & Color of Materials Sand, Clay, Red Clay, Shell, etc.	Thick- ness Feet	Depth Feet
SANDY CLAY	0	10
CLAY	10	22
SAND	22	31
BLUE SHALE	31	45
SANDY SHALE	45	90
BLUE SHALE	90	110
SOFT SHALE	110	118
SHELLS ST SAND	118	130
GRAY SHALE	130	135

Information upon completion of well:

(1) Diameter 3 1/4 inches.

(2) Total Depth 135 feet.

(3) Water Level 55' feet below top of ground.

(4) Cased to 122', Size 2"

(5) Screen: Size 2', Length 6'


(6) Were any formations sealed against pollution?  
 \_\_\_\_\_ yes, \_\_\_\_\_ no.

If YES depth of formation \_\_\_\_\_

Why \_\_\_\_\_

Drillers Remarks: \_\_\_\_\_

CODED

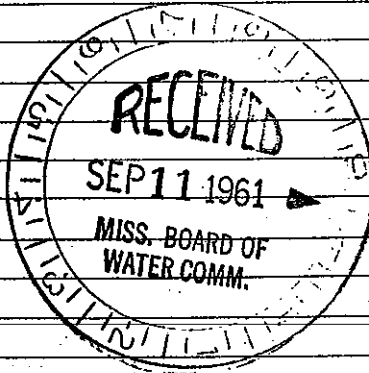

Well No.

(Use Back Side)