

L400.
T 39
6-62

MISSISSIPPI BOARD OF WATER COMMISSIONERS

WATER WELL DRILLERS LOG **CODED**


Date: 6-, 1962, Driller: M^r Donald & Hill County Landmark
(Name)

(1) Owner of Land:	Description & Color of Materials Sand, Clay, Red Clay, Shell, etc.	Thick- ness Feet	Depth Feet
<u>Willis L. Cooper</u> (Name)	<u>Clay</u>	<u>0</u>	<u>10</u>
<u>Rt. #7, Meridian</u> (Address)	<u>Sand & clay</u>	<u>10</u>	<u>60</u>
<u>28 517</u>	<u>Shale</u>	<u>60</u>	<u>80</u>
(2) Location: <u>1/4</u> , <u>28</u> Sec. <u>517</u> T <u>R</u>	<u>Sand</u>	<u>80</u>	<u>98</u>
<u>17</u> miles <u>S.E.</u> of <u>Meridian</u> (distance) (direction) (Nearest Town)			
(3) Topography: <input checked="" type="checkbox"/> (Hilly) <input type="checkbox"/> (Flat) <input type="checkbox"/> (Level)			
(4) Purpose of Well: <u>Domestic</u> (Domestic Irrigation Municipal, Industrial, Other)			

Information upon completion of well:

- (1) Diameter 2" inches.
- (2) Total Depth 98 feet.
- (3) Water Level 43 feet below top of ground.
- (4) Cased to 9.2, Size 2"
- (5) Screen: Size 2"; Length 3'
- (6) Were any formations sealed against pollution?
no

CODED

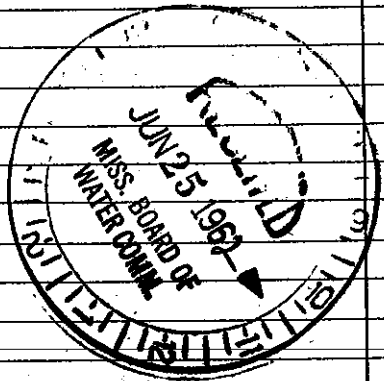

If YES depth of formation _____
Why _____
Drillers Remarks: _____

Well No.

(Use Back Side)

Mail this copy to Board of Water Commissioners 429 Miss. St. Jackson, Miss