

LAND.

T 40

7-26-62


MISSISSIPPI BOARD OF WATER COMMISSIONERS

WATER WELL DRILLERS LOG

CODED

Date: 7-26, 1962, Driller: Mrs Donald L Hill County: Madison
(Name)

		Description & Color of Materials Sand, Clay, Red Clay, Shell, etc.	Thick- ness Feet	Depth Feet
(1) Owner of Land: <u>M.C. Covington</u> (Name)				
<u>Rt # 3 Meridian, Miss.</u> (Address)		<u>Clay</u>	<u>0</u>	<u>10</u>
(2) Location: <u>1/4, 1/4 Sec. T. R. 1</u> <u>17 miles South E. of Meridian</u> (distance) (direction) (Nearest Town)		<u>Sand</u>	<u>10</u>	<u>45</u>
		<u>Rock</u>	<u>45</u>	<u>46</u>
(3) Topography: <input checked="" type="checkbox"/> (Hilly) <input type="checkbox"/> (Flat) <input type="checkbox"/> (Level)		<u>Shale</u>	<u>46</u>	<u>60</u>
(4) Purpose of Well: <u>Domestic</u> (Domestic Irrigation, Municipal, Industrial, Other)		<u>Sand</u>	<u>60</u>	<u>90</u>
		<u>Shale</u>	<u>90</u>	<u>114</u>
		<u>Rock</u>	<u>114</u>	<u>115</u>
		<u>Shale</u>	<u>115</u>	<u>125</u>
		<u>Sandy Shale</u>	<u>125</u>	<u>140</u>
		<u>Shale</u>	<u>140</u>	<u>178</u>
		<u>lft. rock Soft Shale</u>	<u>178</u>	<u>183</u>
Information upon completion of well:			<u>183</u>	<u>195</u>
(1) Diameter: <u>4</u> inches.		<u>Rock</u>	<u>195</u>	<u>197</u>
(2) Total Depth: <u>400</u> feet.		<u>Soft Shale</u>	<u>197</u>	<u>212</u>
(3) Water Level: <u>136</u> feet below top of ground.		<u>Sandy Shale</u>	<u>212</u>	<u>235</u>
(4) Cased to: <u>168</u> , Size: <u>4"</u>		<u>Shale</u>	<u>235</u>	<u>255</u>
(5) Screen: Size: <u>1/2"</u> , Length: <input checked="" type="checkbox"/>		<u>Shale St. Rock</u>	<u>255</u>	<u>270</u>
(6) Were any formations sealed against pollution? <input checked="" type="checkbox"/> yes, <input type="checkbox"/> no.		<u>Shale</u>	<u>270</u>	<u>300</u>
If YES depth of formation _____		<u>Sand</u>	<u>300</u>	<u>310</u>
Why _____		<u>Shale</u>	<u>310</u>	<u>320</u>
Drillers Remarks: _____		<u>Sand</u>	<u>320</u>	<u>330</u>
		<u>Shale</u>	<u>330</u>	<u>380</u>
		<u>Sand</u>	<u>380</u>	<u>400</u>

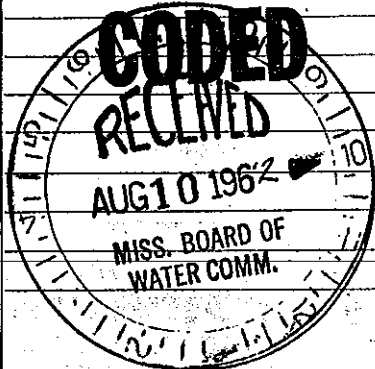

(Use Back Side)

Well No.

Mail this copy to Board of Water Commissioners 429 Miss. St. Jackson, Miss