

MISSISSIPPI BOARD OF WATER COMMISSIONERS

L.A.U.O.  
T 41  
2-14-63

WATER WELL DRILLERS LOG

**CODED**

McDONALD & HILL, Inc.

Date: 2-14, 1963, Driller: \_\_\_\_\_ County Laud.

(Name) \_\_\_\_\_

(1) Owner of Land: Buford E. Miller  
(Name)

Rt # 3 Meridian  
(Address)

(2) Location: 1/4, 1/4, Sec. 19 5 13 T. 1 R. 13

12 miles SE of Meridian  
(distance) (direction) (Nearest Town)

(3) Topography: \_\_\_\_\_  
(Hilly) (Flat) (Level)

(4) Purpose of Well: Domestic  
(Domestic Irrigation, Municipal, Industrial, Other)


Information upon completion of well:

- (1) Diameter 4 inches.  
(2) Total Depth 480 feet.  
(3) Water Level 170 feet below top of ground.  
(4) Cased to 294, Size 4  
(5) Screen: Size \_\_\_\_\_, Length \_\_\_\_\_  
(6) Were any formations sealed against pollution?  
\_\_\_\_\_ yes,  no.

If YES, depth of formation \_\_\_\_\_

Why \_\_\_\_\_

Drillers Remarks: \_\_\_\_\_

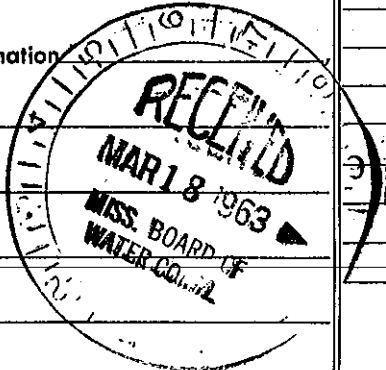

Description & Color of Materials  
Sand, Clay, Red Clay, Shell, etc.

Thick-  
ness  
Feet

Depth  
Feet

Clay	0	10
Clay st. sand	10	50
Shale	50	390
S. Fine Sand	390	420
Soft Shale	420	450
Sand	450	480

**CODED**

(Use Back Side)

Well No.

Mail this copy to Board of Water Commissioners 429 Miss. St. Jackson, Miss.