

MISSISSIPPI BOARD OF WATER COMMISSIONERS

L.A.U.D.

WATER WELL DRILLERS LOG


CODED

T 44
6-6-63

Date: 6-6-1963, Driller: McDonald & Hill County: Lauderdale
(Name)

(1) Owner of Land <u>Ray Harrison</u> (Name)	Description & Color of Materials Sand, Clay, Red Clay, Shell, etc.	Thick- ness Feet	Depth Feet
(Address)	Clay	0	8
(2) Location: 1/4, 1/4, Sec. <u>1 5 17</u> T. R.	sd. Sdy Clay	8	28
<u>15</u> miles <u>East</u> , of <u>Meridian</u> (distance) (direction) (Nearest Town)	Shale	28	40
(3) Topography: <u>Hilly</u> (Hilly) (Flat) (Level)	Sand	40	40
(4) Purpose of Well: <u>Domestic</u> (Domestic Irrigation Municipal, Industrial, Other)	Shale w/ sd. streaks	40	66
Information upon completion of well:	Limey shale & lime	66	70
(1) Diameter: <u>3 1/4</u> inches.	Sdy. shale	70	79
(2) Total Depth: <u>400</u> feet.	Shale w/ lig. streaks	79	90
(3) Water Level: <u>220</u> feet below top of ground.	Shale - sd. & lig	90	120
(4) Cased to: <u>317</u> , Size <u>4"</u>	Sdy shale & lig	120	180
(5) Screen: Size _____, Length _____	Sand	180	180
(6) Were any formations sealed against pollution? _____ yes, _____ no.	Shale	180	307
If YES depth of formation _____	Sand	307	314
Why _____	Shale	314	328
Drillers Remarks: _____	Sand w/ shale streaks	328	341
	Shale	341	350
	Sdy. shale	350	360
	sd. sdy. shale	360	430
	Sand	430	400
	Sdy. shale	400	400

CODED

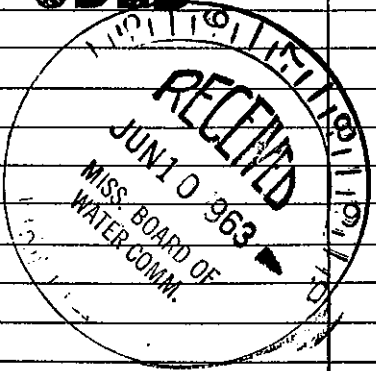

(Use Back Side)

Well No.

Mail this copy to Board of Water Commissioners 429 Miss. St. Jackson, Miss.