

LAUD.

MISSISSIPPI BOARD OF WATER COMMISSIONERS

T 95  
6-24-63

WATER WELL DRILLERS LOG  
McDONALD & HILL, Inc.

**CODED**

Date: 6.24, 1963, Driller: P. O. Box 81 County: LAUDERDALE

MERIDIAN, MISSISSIPPI

(1) Owner of Land: <u>Herndale Simmons</u> (Name)	Description & Color of Materials Sand, Clay, Red Clay, Shell, etc.	Thick- ness Feet	Depth Feet
<u>Plt #6</u> (Address)	CLAY	0	10
(2) Location: <u>1/4, 1/4, Sec. 14 5 17 T. R.</u>	SHALE	10	42
<u>1.5</u> miles <u>S.E.</u> of <u>Meridian</u> (distance) (direction) (Nearest Town)	SOFT SHALE	42	100
(3) Topography: <u>X</u> (Hilly) (Flat) (Level)	SHALE	100	140
(4) Purpose of Well: <u>DOMESTIC</u> (Domestic Irrigation Municipal, Industrial, Other)	SOFT SHALE LIGNITE	140	268
	ROCK	268	270
	SHALE	270	308
	SANDY SHALE	300	340
	FINE SANDY	340	360

Information upon completion of well:


- (1) Diameter 4" inches.
- (2) Total Depth 360' feet.
- (3) Water Level 160' feet below top of ground.
- (4) Cased to 270', Size 4"
- (5) Screen: Size \_\_\_\_\_, Length \_\_\_\_\_.
- (6) Were any formations sealed against pollution?  
\_\_\_\_\_ yes, \_\_\_\_\_ no.

If YES depth of formation \_\_\_\_\_

Why \_\_\_\_\_

Drillers Remarks: \_\_\_\_\_

**CODED**

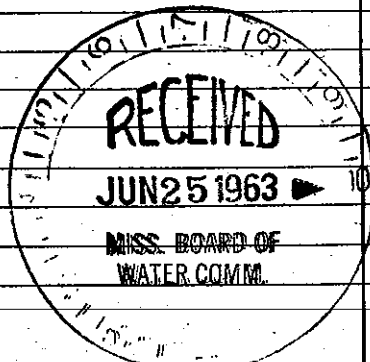

(Use Back Side)

Well No.

Mail this copy to Board of Water Commissioners 429 Miss. St. Jackson, Miss.