

LAUD. MISSISSIPPI BOARD OF WATER COMMISSIONERS

T 47
9-10-63

WATER WELL DRILLERS LOG

CODED

Date: 9-10, 1963, Driller: Mr. Donald Hill County Lauderdale
(Name)

(1) Owner of Land: <u>James Riley</u> (Name)	Description & Color of Materials Sand, Clay, Red Clay, Shell, etc.	Thick- ness Feet	Depth Feet
(Address)	<u>Clay</u>	<u>0</u>	<u>17</u>
(2) Location: <u>28 517</u> <u>1/4</u> , <u>1/4</u> , Sec. <u>T</u> <u>R</u>	<u>Sand</u>	<u>17</u>	<u>21</u>
<u>14</u> miles <u>East</u> of <u>Meridian</u> (distance) (direction) (Nearest Town)	<u>Shale & lignite</u>	<u>21</u>	<u>30</u>
(3) Topography: <u>Hilly</u> (Hilly) (Flat) (Level)	<u>Shale</u>	<u>30</u>	<u>130</u>
(4) Purpose of Well: <u>Domestic</u> (Domestic Irrigation Municipal, Industrial, Other)	<u>Lime</u>	<u>130</u>	<u>136</u>
	<u>Sand</u>	<u>136</u>	<u>140</u>
	<u>Shale</u>	<u>140</u>	<u>206</u>
	<u>lignite</u>	<u>206</u>	<u>208</u>
	<u>Shale</u>	<u>208</u>	<u>398</u>
	<u>Sandy shale & sand</u>	<u>398</u>	<u>430</u>
	<u>Shale</u>	<u>430</u>	<u>?</u>

Information upon completion of well:


- (1) Diameter 3 7/8 inches.
- (2) Total Depth 430 feet.
- (3) Water Level 110 feet below top of ground.
- (4) Cased to 197, Size 4
- (5) Screen: Size _____, Length _____
- (6) Were any formations sealed against pollution?
_____ yes, _____ no.

If YES depth of formation _____

Why _____

Drillers Remarks: _____

CODED

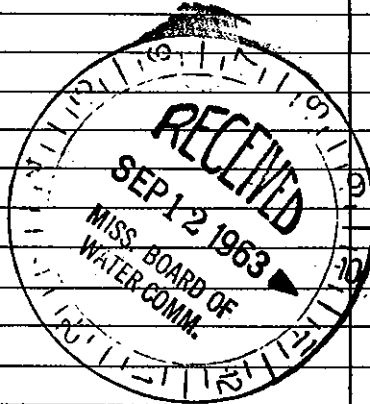

Well No.
107

(Use Back Side)

Mail this copy to Board of Water Commissioners 429 Miss. St. Jackson, Miss