

CAUD.  
T48  
3-14-66

WATER WELL DRILLERS LOG


Date: 3-14, 1966, Driller: m<sup>e</sup> Donald & Hill In Wade County Wade

**CODED**

(Name)

(1) Owner of Land: ROY IVEY  
(Name)  
RH-#7 MERIDIAN, m. 25  
(Address)  
(2) Location: 1/4, 1/4, Sec. 5 17  
7 miles S.E., of Meridian  
(distance) (direction) (Nearest Town)  
(3) Topography: X  
(Hilly) (Flat) (Level)  
(4) Purpose of Well: DOMESTIC  
(Domestic Irrigation  
Municipal, Industrial, Other)

Description & Color of Materials Sand, Clay, Red Clay, Shell, etc.	Thick- ness Feet	Depth Feet
<u>CLAY</u>	<u>0</u>	<u>30</u>
<u>SHALE ST CLAY</u>	<u>30</u>	<u>75</u>
<u>SAND ST CLAY</u>	<u>75</u>	<u>132</u>
<u>SHALE</u>	<u>132</u>	<u>147</u>
<u>SANDY SHALE</u>	<u>147</u>	<u>169</u>
<u>SHALE</u>	<u>169</u>	<u>176</u>
<u>SOFT TOMED SHALE</u>	<u>176</u>	<u>180</u>
<u>SANDY</u>	<u>180</u>	<u>200</u>
<u>SHALE</u>	<u>200</u>	<u>240</u>
<u>SAND</u>	<u>240</u>	<u>260</u>

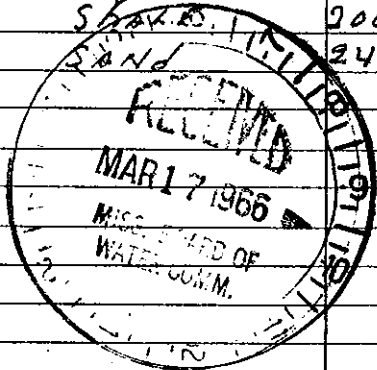

**CODED**

Information upon completion of well:

(1) Diameter 4" inches. WELL

(2) Total Depth 260' feet.

(3) Water Level 200' feet below top of ground.

(4) Cased to 172, Size 4" BLDG

(5) Screen: Size \_\_\_\_\_, Length \_\_\_\_\_

(6) Were any formations sealed against pollution?  
\_\_\_\_\_ yes, \_\_\_\_\_ no.

If YES depth of formation \_\_\_\_\_

Why \_\_\_\_\_

Drillers Remarks: \_\_\_\_\_

Well No.

(Use Back Side)

Mail this copy to Board of Water Commissioners 429 Miss. St. Jackson, Miss