

LAUD.

T49

7-12-66

MISSISSIPPI BOARD OF WATER COMMISSIONERS

WATER WELL DRILLERS LOG

CODED

Date: 7-12, 1966, Driller: McDONALD HILL County LAUD.
(When well drilled) (Name) (Where well is located)

(1) Owner of Land: James Irby
(Name)
RT 7 MDN
(Address)

(2) Location: 2 1/2 Sec. 5 (T R)
in Causeyville
miles of _____
(distance) (direction) (Nearest Town)

(3) Topography: Hilly
(Hilly) (Flat) (Level)

(4) Purpose of Well: DOMESTIC
(Domestic Irrigation
Municipal, Industrial, Other)

| Description & Color of Materials Sand, Clay, Red Clay, Shell, etc. | Thick- ness Feet | Depth Feet |
|---|------------------------|---------------|
| CLAY | 0 | 14 |
| SOFT SHALE SANDY | 14 | 70 |
| M BLY SHALE | 70 | 80 |
| SOFT BLK SHALE | 80 | 100 |
| M SHALE | 100 | 108 |
| ROCK | 108 | 110 |
| 2 1/2 SOFT SHALE | 110 | 130 |
| M SHALE | 130 | 140 |
| 2 1/2 SOFT SHALE | 140 | 168 |
| M SHALE 2 1/2 STIP | 168 | 250 |
| ROCK | 250 | 251 |
| SHALE | 251 | 288 |
| FINE SAND SANDY | 288 | 330 |

Information upon completion of well:

(1) Diameter 4 inches.

(2) Total Depth 330 feet.


(3) Water Level 125 feet below top of ground.

(4) Cased to 194, Size 4

(5) Screen: Size _____, Length _____

(6) Were any formations sealed against pollution?
_____ yes, _____ no.

CODED

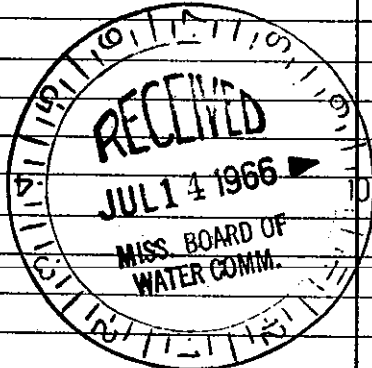

If YES depth of formation _____

Why _____

Drillers Remarks: _____

Yield in gpm: _____

Size pump: _____

Type power: _____

Mail this copy to Board of Water Commissioners 429 Miss. St. Jackson, Miss.