

Lauderdale  
U3  
2-67

MISSISSIPPI  
BOARD OF WATER COMMISSIONERS  
416 North State Street  
Jackson, Mississippi 39201

WATER WELL DRILLERS LOG

2.2.67 19 MCDONALD HILL LAUDERDALE  
date well completed firm name county well located


LANDOWNER: WILLIE COOPER  
R# 7 MERIDIAN  
(mailing address)

WELL LOCATION:  
sec. 34 T 5 N R 18 E  
S W  
8 miles SEAST of WBYHOT  
(distance) (direction) (nearest town)

WELL PURPOSE:  
(home, irrigation, municipal, industrial)

- WELL COMPLETION DATA:
- (1) diameter (inches) 4" WELL
  - (2) total depth (feet) 417'
  - (3) static water level (feet) 185' <sup>below</sup> above top of ground.
  - (4) casing BLACK, 250'  
(material) (depth)  
4"  
(size) If telescope see back.
  - (5) screen NO, NO  
(length) (depth to top)  
NO, NO  
(size) (material)
  - (6) pump 34 SUB 10  
(HP) (yield gpm)  
230  
(type power)
  - (7) electric log NO  
(yes or no)  
NO  
(organization running log)
  - (8) how well bottom plugged OPEN

| description of formations encountered | from to |     |
|---------------------------------------|---------|-----|
|                                       |         |     |
| CLAY                                  | 0       | 35  |
| SAND ST CLAY                          | 35      | 98  |
| SHALE                                 | 98      | 135 |
| ROCK                                  | 135     | 137 |
| SHALE ST LIGNITE                      | 137     | 197 |
| ROCK                                  | 197     | 198 |
| SHALE ST LIGNITE                      | 198     | 250 |
| SHALE                                 | 250     | 300 |
| SAND                                  | 300     | 312 |
| SHALE                                 | 312     | 375 |
| SANDY SAND                            | 375     | 400 |
| SAND                                  | 400     | 417 |

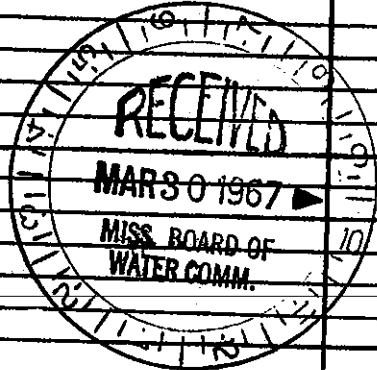

DRILLERS REMARKS: