


LAUD. MISSISSIPPI BOARD OF WATER COMMISSIONERS

FUS  
8-17-65

WATER WELL DRILLERS LOG

Date: 8/17, 1965, Driller: Jerry Drilling SCARBOROUGH County Laud.  
(Name)

(1) Owner of Land: <u>BOBBY LEE Boyd</u> (Name)	Description & Color of Materials Sand, Clay, Red Clay, Shell, etc.	Thick- ness Feet	Depth Feet
<u>RT 7, MERIDIAN, MISS</u> (Address)	<u>YELLOW CLAY &amp; SAND</u>	<u>0</u>	<u>32'</u>
(2) Location: <u>1/4, 1/4, Sec. 7 T R</u>	<u>SANDY SHALE &amp; MUD</u>	<u>32</u>	<u>220'</u>
<u>12</u> miles <u>EAST</u> of <u>MDN.</u> (distance) (direction) (Nearest Town)	<u>HARD SHALE</u>	<u>220</u>	<u>320'</u>
(3) Topography: <input checked="" type="checkbox"/> (Hilly) <input type="checkbox"/> (Flat) <input type="checkbox"/> (Level)	<u>SANDY STREAKS</u>	<u>320</u>	<u>395'</u>
(4) Purpose of Well: <u>DOMESTIC</u> (Domestic, Irrigation, Municipal, Industrial, Other)			
Information upon completion of well:			
(1) Diameter <u>4</u> inches.			
(2) Total Depth <u>395</u> feet.			
(3) Water Level <u>165'</u> feet below top of ground.			
(4) Cased to <u>189'</u> , Size <u>4"</u>			
(5) Screen: Size <u>No</u> , Length _____			
(6) Were any formations sealed against pollution? _____ yes, _____ no.			
If YES depth of formation _____			
Why _____			
Drillers Remarks: <u>Good water</u>			

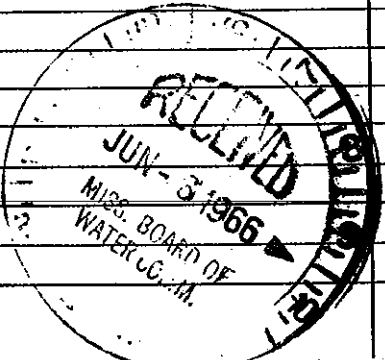

Well