

LAUD. MISSISSIPPI BOARD OF WATER COMMISSIONERS

F 06

WATER WELL DRILLERS LOG

5-14-63

Date: 5-14-1963, Driller: Mc Donald & Hill County Lauderdale
(Name)

(1) Owner of Land: Randolph Carley
(Name)
Route 7
(Address)

(2) Location: 1/4, 1/4, Sec. 7 T. R
12 miles East, of Meridian
(distance) (direction) (Nearest Town)

(3) Topography: Hilly
(Hilly) (Flat) (Level)

(4) Purpose of Well: Domestic
(Domestic Irrigation
Municipal, Industrial, Other)

Description & Color of Materials Sand, Clay, Red Clay, Shell, etc.	Thick- ness Feet	Depth Feet
clay	0	12
clay & sand	12	17
sh.	17	30
chalk	30	35
clay w/ sds - breaks	35	52
clay & chalk w/ sds	52	80
sh.	80	100
sd & soft clay	100	140
shale	140	159
hard lime rock	159	162
shale	162	230
shy shale	230	235
shale (lime str. @ 230)	235	270
shy shale	270	276
shale w/ lign. str.	276	290
shy shale w/ lign. str.	290	320
shale w/ lign. str.	320	348
sh. w/ thin sh. str.	348	385
shy shale & sds	385	390
sh.	390	400
shale	400	410

Information upon completion of well:

(1) Diameter 3 1/4 inches.

(2) Total Depth 410 feet.

(3) Water Level 125 feet below top of ground.

(4) Cased to 228, Size 4


(5) Screen: Size _____, Length _____

(6) Were any formations sealed against pollution?
_____ yes, _____ no.

If YES depth of formation _____

Why _____

Drillers Remarks: _____

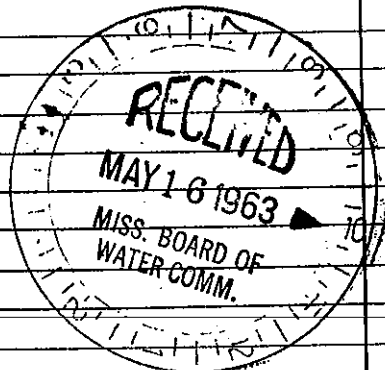

Well