


LAUD. MISSISSIPPI BOARD OF WATER COMMISSIONERS

F⁰⁷
12-11-63

WATER WELL DRILLERS LOG

Date: 12-11, 1963, Driller: McDonald & Will County Lauderdale
(Name)

(1) Owner of Land: <u>Clyde Robinson</u> (Name)	Description & Color of Materials Sand, Clay, Red Clay, Shell, etc.	Thick- ness Feet	Depth Feet
<u>Route 7</u> (Address)	<u>sh. - sandy clay</u>	0	15
(2) Location: <u>1/4, 1/4, Sec. 7 T R</u>	<u>Chalk & clay</u>	15	20
<u>12</u> miles <u>E</u> , of <u>Meridian</u> (distance) (direction) (Nearest Town)	<u>Shale w/ light streaks</u>	20	50
(3) Topography: <u>Hilly</u> (Hilly) (Flat) (Level)	<u>Clay, chalk & sand</u>	50	170
(4) Purpose of Well: <u>Domestic</u> (Domestic Irrigation Municipal, Industrial, Other)	<u>Shale</u>	170	190
Information upon completion of well:	<u>sand w/ shale streaks</u>	190	202
(1) Diameter <u>3 7/8</u> inches.	<u>sand</u>	202	218
(2) Total Depth <u>0' 50"</u> feet.	<u>sand w/ shale streaks</u>	218	223
(3) Water Level <u>310</u> feet below top of ground.	<u>shale</u>	223	230
(4) Cased to <u>334</u> , Size <u>4</u>	<u>sh. shale & sand</u>	230	242
(5) Screen: Size _____, Length _____	<u>shale w/ calc. sh. lig.</u>	242	275
(6) Were any formations sealed against pollution? _____ yes, _____ no.	<u>shale</u>	275	505
If YES depth of formation _____	<u>sandy shale w/ calc. sh.</u>	505	550
Why _____			
Drillers Remarks: _____			

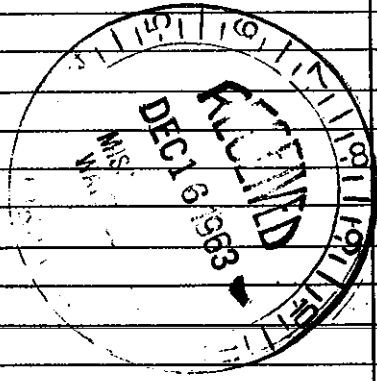

(Use Back Side)

Well No.