


LAUD. MISSISSIPPI BOARD OF WATER COMMISSIONERS

F 08
9-30-63

WATER WELL DRILLERS LOG

Date: 9-30, 1963, Driller: McDaniel & Sons, Lumberton, Mississippi

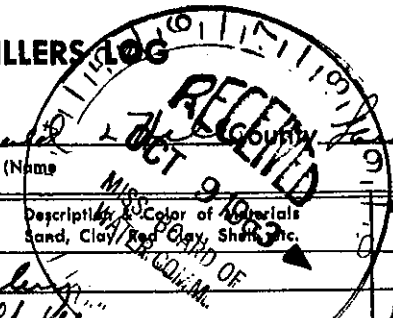

(1) Owner of Land: W. J. Raley
(Name)
Meridian, Rt 7
(Address)
(2) Location: 1/4, 21 T. R.
14 miles East of Meridian
(distance) (direction) (Nearest Town)
(3) Topography: Hilly
(Hilly) (Flat) (Level)
(4) Purpose of Well: Domestic
(Domestic Irrigation, Municipal, Industrial, Other)

| Description of Materials Sand, Clay, Red Clay, Shale, etc. | Thickness Feet | Depth Feet |
|---|-------------------|---------------|
| Clay | 0 | 17 |
| Shale | 17 | 50 |
| Sandy shale & sand | 50 | 58 |
| Shale | 58 | 100 |
| soft lime | 100 | 108 |
| Shale | 108 | 150 |
| Shale w/pt. Red shale | 150 | 170 |
| Sandy shale | 170 | 177 |
| Shale w/ red streaks | 177 | 190 |
| Sandy shale w/pt. st. | 190 | 196 |
| Shale | 196 | 210 |
| Sandy shale | 210 | 220 |
| Shale w/ some lig. | 220 | 270 |
| Hard sandy shale | 270 | 278 |
| Shale | 278 | 370 |
| Sandy shale w/ shale st. | 370 | 392 |
| Fine sand w/ shale st. | 392 | 410 |
| Sandy shale | 410 | 420 |

Information upon completion of well:

(1) Diameter: 3 7/8 inches.
(2) Total Depth: 420 feet.
(3) Water Level: 122 feet below top of ground.
(4) Cased to: 247, Size 4"
(5) Screen: Size _____, Length _____
(6) Were any formations sealed against pollution?
_____ yes, _____ no.

If YES depth of formation _____
Why _____
Drillers Remarks: _____

(Use Back Side)

Well No
114