

LAUD.

MISSISSIPPI BOARD OF WATER COMMISSIONERS

# U10

7-9-65

WATER WELL DRILLERS LOG

Date: 7-9, 1965, Driller: McDONALD + HILL County LAUDERDALE

(Name)

(1) Owner of Land: W.E. COOPER (Name)  
Rt. #17, Meridian, Miss (Address)

(2) Location: 1/4, 1/4, Sec. 22 T. R.  
15 miles S.E. of Meridian (distance) (direction) (Nearest Town)

(3) Topography: Hilly (Hilly) (Flat) (Level)


(4) Purpose of Well: DOMESTIC (Domestic Irrigation Municipal, Industrial, Other)

| Description & Color of Materials<br>Sand, Clay, Red Clay, Shell, etc. | Thick-<br>ness<br>Feet | Depth<br>Feet |
|---|------------------------|---------------|
| CLAY + Sand   | 0                      | 75            |
| BROWN + BLK SHALE STA   | 75                     | 90            |
| H Shale   | 90                     | 112           |
| Soft Shale  | 112                    | 127           |
| Sandy Shale   | 127                    | 165           |
| medium to H Shale   | 165                    | 170           |

Information upon completion of well:

- (1) Diameter 4 inches.
- (2) Total Depth 170 feet.
- (3) Water Level 80 feet below top of ground.
- (4) Cased to 105, Size 4
- (5) Screen: Size, Length
- (6) Were any formations sealed against pollution?  
yes,  no.

If YES depth of formation  
Why  
Drillers Remarks:

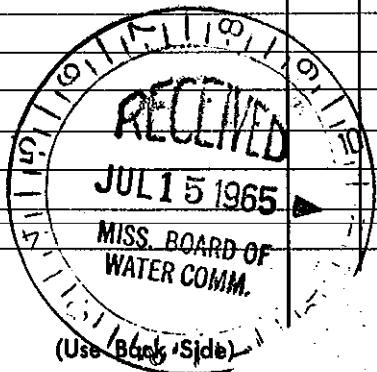

Mail this copy to Board of Water Commissioners 429 Miss. St